

MISSISSIPPI DEPARTMENT OF NATURAL RESOURCES

Bureau of Land and Water Resources

PEARL RIVER

U 127  
3/17/82

BUD PENTON & SON  
WATER WELL SERVICE  
ROUTE 4 BOX 402  
CARRIERS, MS 39426  
PHONE 798-5324

Southport Mall  
P.O. Box 10631

Jackson, Mississippi 39209

371

WATER WELL DRILLERS LOG

BUD PENTON & SON  
WATER WELL SERVICE  
ROUTE 4 BOX 402  
CARRIERS, MS 39426  
PHONE 798-5324

Pearl River  
county well located

3/17 1982  
date well completed

LANDOWNER: Mike Davis  
Liberty Road  
B.T. Carrington  
(mailing address)

WELL LOCATION:  
sec. 28 T. 5 N. R. 17 E.  
2 miles W of Osage  
(distance) (direction) (nearest town)

WELL PURPOSE: Tractor pull  
(home, irrigation, municipal, industrial)

WELL COMPLETION DATA:  
(1) diameter (inches) 2"  
(2) total depth (feet) 630  
(3) static water level (feet) 14 ft <sup>below</sup> <sub>above</sub> top of ground.  
(4) casing galv. 610 +32'  
(material) (depth)  
         If telescope see back.  
(size)  
(5) screen 2x2 610  
(length) (depth to top)  
12 SS Steel  
(size) (material)  
(6) pump 1 1/2 2700  
(HP) (yield gpm)  
Elect 45gpm  
(type power)  
(7) electric log no  
(yes or no)  
          
(organization running log)

description of formations encountered	from	to
<u>white shale</u>	<u>0</u>	<u>10</u>
<u>white sand</u>	<u>10</u>	<u>63</u>
<u>blue shale</u>	<u>63</u>	<u>140</u>
<u>blue sand</u>	<u>140</u>	<u>170</u>
<u>blue shale</u>	<u>170</u>	<u>189</u>
<u>blue sand</u>	<u>189</u>	<u>195</u>
<u>blue shale</u>	<u>195</u>	<u>242</u>
<u>blue sand</u>	<u>242</u>	<u>368</u>
<u>blue shale</u>	<u>368</u>	<u>533</u>
<u>gray sand</u>	<u>533</u>	<u>630</u>

Elevation: 60 feet

0894245303522

DEPT. OF NATURAL RESOURCES  
BUREAU OF LAND & WATER RESOURCES


JUL - 1 1982  
RECEIVED

(8) how well bottom plugged sand shark

DRILLERS REMARKS:

If well telescopes please sketch and show depths.

GROUND LEVEL

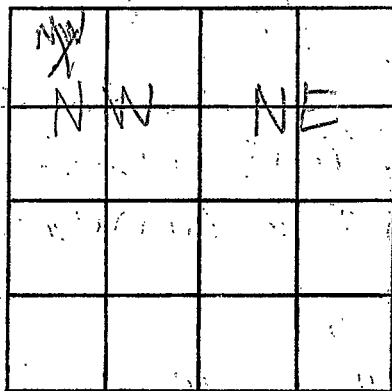

SECTION \_\_\_\_\_

Please indicate well location X.

ADDITIONAL INFORMATION

If more than one screen,  
show locations of each on sketch.