

MISSISSIPPI DEPARTMENT OF NATURAL RESOURCES

Bureau of Land and Water Resources

BUD PENTON & SON Southport Mall
 WATER WELL SERVICE
 ROUTE 4 BOX 402 P.O. Box 10631
 CARRIERE, MS 39426
 PHONE 798-5524

371

WATER WELL DRILLERS LOG

BUD PENTON & SON
 WATER WELL SERVICE
 ROUTE 4 BOX 402
 CARRIERE, MS 39426
 PHONE 798-5524

Pearl River
 county well located

PEARL RIVER
 U 128
 4/27/82

4/27 19
 date well completed

LANDOWNER: *Mr. Landrell*
B.T. & Carriere
Miss
 (mailing address)

WELL LOCATION:
 sec. 9 T. 5 N. R. 17 E.
6 miles W of CARRIERE
 (distance) (direction) (nearest town)

WELL PURPOSE: home
 (home, irrigation, municipal, industrial)

WELL COMPLETION DATA:

(1) diameter (inches) 2"

(2) total depth (feet) 720
 Elevation: 70 feet

(3) static water level (feet) 12 ^{below} above top of ground.
0895725303735

(4) casing pvc, 720, ⁺²⁸
 (material) (depth)

(size) If telescope see back.

(5) screen 2x20, 700
 (length) (depth to top)

12, pvc
 (size) (material)

(6) pump 70
 (HP) (yield gpm)

(type power)

(7) electric log no
 (yes or no)

(organization running log)

description of formations encountered	from	to
<i>Red shale</i>	<i>0</i>	<i>30</i>
<i>Blue shale</i>	<i>30</i>	<i>101</i>
<i>Blue shale</i>	<i>101</i>	<i>200</i>
<i>Blue sand</i>	<i>200</i>	<i>240</i>
<i>Blue shale</i>	<i>240</i>	<i>330</i>
<i>Blue sand</i>	<i>330</i>	<i>470</i>
<i>Blue shale</i>	<i>470</i>	<i>660</i>
<i>Gray sand</i>	<i>660</i>	<i>720</i>


(8) how well bottom plugged
Sand shark

DRILLERS REMARKS: no pump furnished

DEPT. OF NATURAL RESOURCES
 BUREAU OF LAND & WATER RESOURCES
 JUL - 1 1982
RECEIVED

If well telescopes please sketch and show depths.

GROUND LEVEL

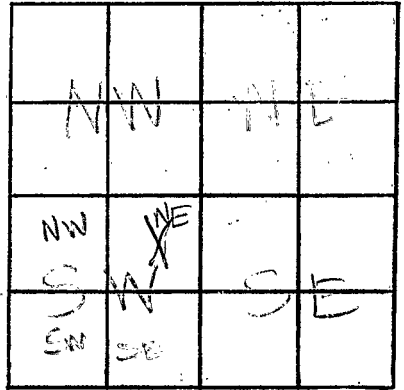

SECTION _____

Please indicate well location X.

ADDITIONAL INFORMATION

If more than one screen,
show locations of each on sketch.