

MISSISSIPPI DEPARTMENT OF NATURAL RESOURCES

Bureau of Land and Water Resources

Southport Mall

P.O. Box 10631

Jackson, Mississippi 39209

WATER WELL DRILLERS LOG

PEARL RIVER  
4129  
2/9/83

CODED

2/9

19

83 *Bob Denton & Son*

*Pearl River*

date well completed

firm name

county well located

*Waterwell Serv.*

LANDOWNER: *Pat Weaver*

description of formations encountered

from

to

*M.T. 4 carrier*

*Red shale*

*0 22*

*Blue shale*

*22 508*

*Gray sand & Rock*

*508 681*

(mailing address)

WELL LOCATION:

sec. *27* T. *5* N R. *17* E

*7* miles *NW* of *Pineville*  
(distance) (direction) (nearest town)

WELL PURPOSE: *home*  
(home, irrigation, municipal, industrial)

WELL COMPLETION DATA:

- (1) diameter (inches) *2"*
- (2) total depth (feet) *681*
- (3) static water level (feet) *10* below above top of ground.

CODED

(4) casing *PVC*, *681*  
(material) (depth)

(size) If telescope see back.

(5) screen *2x20*, *66'*  
(length) (depth to top)

*12*, *PVC*  
(size) (material)

(6) pump *30*  
(HP) (yield gpm)

(type power)

(7) electric log *no*  
(yes or no)

(organization running log)

(8) how well bottom plugged *Sand*  
*Shore*

DEPT. OF NATURAL RESOURCES  
BUREAU OF LAND & WATER RESOURCES


APR 27 1983

RECEIVED

DRILLERS REMARKS:

If well telescopes please sketch and show depths.

GROUND LEVEL

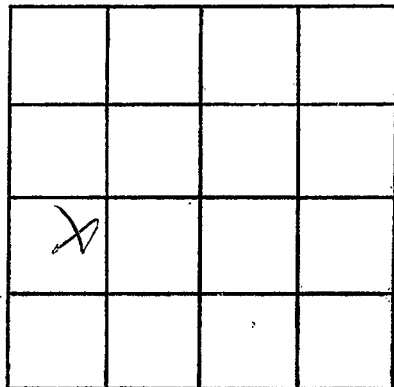

SECTION \_\_\_\_\_

Please indicate well location X.

ADDITIONAL INFORMATION

If more than one screen,  
show locations of each on sketch.