

MISSISSIPPI DEPARTMENT OF NATURAL RESOURCES

Bureau of Land and Water Resources
 Southport Mall
 P.O. Box 10631
 Jackson, Mississippi 39209
 WATER WELLS SERVICE
 ROUTE BOX 402
 CARRIERE, MS 39426
 PHONE 798-5324

PEARL RIVER
 U 4130
 121111982

CODED

BUD FENTON & SON
 WATER WELLS DRILLERS LOG
 ROUTE BOX 402
 CARRIERE, MS 39426
 PHONE 798 5324

12/11/82
 date well completed

Pearl River
 county well located

LANDOWNER: M W Wandery
R-T-6 Box 312
Picoyne Miss.
 (mailing address)

description of formations encountered	from	to
White shale	0	10
White sand rock	10	60
Blue shale	60	210
Blue sand	210	380
Blue shale	380	700
Gray sand	700	700

WELL LOCATION:
 sec. 36 T. 5 N R. 17 E
~~East 6~~ miles West of Picoyne
 (distance) (direction) (nearest town)

WELL PURPOSE: home
 (home, irrigation, municipal, industrial)

CODED

WELL COMPLETION DATA:

(1) diameter (inches) 2"

(2) total depth (feet) 750

(3) static water level (feet) 866 below/above top of ground.

(4) casing PVC 750
 (material) (depth)

_____ If telescope see back.
 (size)

(5) screen 2x20 730
 (length) (depth to top)

12 PVC
 (size) (material)

(6) pump 70 _____
 (HP) (yield gpm)

_____ (type power)

(7) electric log no
 (yes or no)

_____ (organization running log)


(8) how well bottom plugged sand
shark

DEPT. OF NATURAL RESOURCES
 BUREAU OF LAND & WATER
 APR 27 1983
RECEIVED

DRILLERS REMARKS:

If well telescopes please sketch and show depths.

GROUND LEVEL

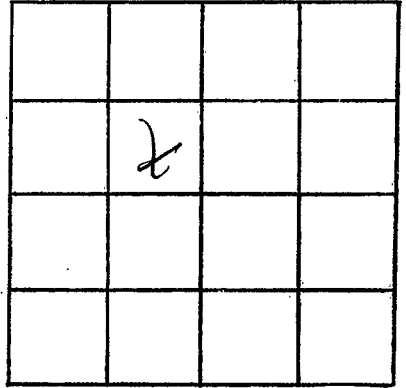

SECTION _____

Please indicate well location X.

ADDITIONAL INFORMATION

If more than one screen,
show locations of each on sketch.