

# MISSISSIPPI DEPARTMENT OF NATURAL RESOURCES

Bureau of Land and Water Resources

Southport Mall

P.O. Box 10631

Jackson, Mississippi 39209

## WATER WELL DRILLERS LOG

**CODED**

|             |
|-------------|
| Pearl River |
| U 133       |
| 1984        |

19 84 PENTON WELL SERV. firm name      PEARL RIVER county well located

LANDOWNER: KENNY HOLMES  
  
Nicholson MS.  
(mailing address)

| description of formations encountered | from       | to         |
|---------------------------------------|------------|------------|
| <u>SURFACE CLAY</u>                   | <u>0</u>   | <u>15</u>  |
| <u>SAND</u>                           | <u>15</u>  | <u>80</u>  |
| <u>Blue CLAY</u>                      | <u>80</u>  | <u>280</u> |
| <u>SAND</u>                           | <u>280</u> | <u>355</u> |
| <u>Blue CLAY</u>                      | <u>355</u> | <u>560</u> |
| <u>SAND</u>                           | <u>560</u> | <u>610</u> |

WELL LOCATION:  
sec. 33 T. 5 N. R. 17 E.  
                    S                      W  
2 miles North of Pineyune  
(distance) (direction) (nearest town)

WELL PURPOSE: HOME  
(home, irrigation, municipal, industrial)

WELL COMPLETION DATA:

(1) diameter (inches) 2

(2) total depth (feet) 610'

(3) static water level (feet) Flow <sup>below</sup> above top of ground.

(4) casing PVC, 600',  
(material) (depth)  
2 If telescope see back.  
(size)

(5) screen 10', 600',  
(length) (depth to top)  
2, PVC  
(size) (material)

(6) pump 1/2,  
(HP) (yield gpm)  
Elec  
(type power)

(7) electric log NO  
(yes or no)  
  
(organization running log)

(8) how well bottom plugged B.W.

**CODED**

**RECEIVED**


JAN 24 1985

Department of Natural Resources  
Bureau of Land & Water Resources

DRILLERS REMARKS:

If well telescopes please  
sketch and show depths.

GROUND LEVEL

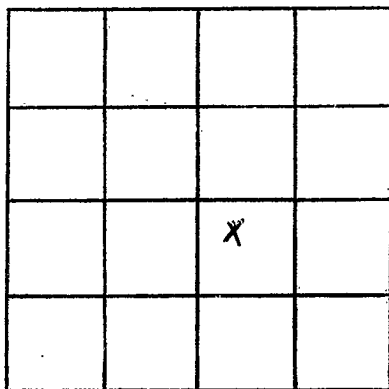

SECTION 33

Please indicate well location X.

ADDITIONAL INFORMATION

If more than one screen,  
show locations of each on sketch.