

MISSISSIPPI DEPARTMENT OF NATURAL RESOURCES
Bureau of Land and Water Resources
 Southport Mall
 P.O. Box 10631
 Jackson, Mississippi 39209
WATER WELL DRILLERS LOG

CODED

Pearl River
U 134
1/11/85

1-11 1985 PENTON WELL SERV. PEARL RIVER
 date well completed firm name county well located

LANDOWNER: R.V. LANGSTON
? Rt. Picayune
 (mailing address)

WELL LOCATION:
 sec. 32 T. 5 N R. 17 E
 S W
2 miles NW of Picayune
 (distance) (direction) (nearest town)

WELL PURPOSE: HOME
 (home, irrigation, municipal, industrial)

- WELL COMPLETION DATA:
- (1) diameter (inches) 2
 - (2) total depth (feet) 1116'
 - (3) static water level (feet) Flow ^{below} above top of ground.
 - (4) casing PVC 1096'
 (material) (depth)
2 if telescope see back.
 (size)
 - (5) screen 20' 1096'
 (length) (depth to top)
2 PVC
 (size) (material)
 - (6) pump _____ (HP) _____ (yield gpm)
 (type power)
 - (7) electric log NO
 (yes or no)
 (organization running log)
 - (8) how well bottom plugged B.W.

description of formations encountered	from	to
SURFACE CLAY	0	37
SAND	37	65
BLUE CLAY	65	270
SAND	270	385
BLUE CLAY	385	510
SAND	510	582
BLUE CLAY	582	710
SILT	710	750
BLUE CLAY	750	1020
SAND	1020	1116

CODED


RECEIVED
 JAN 24 1985

Department of Natural Resources
 Bureau of Land & Water Resources

DRILLERS REMARKS:

If well telescopes please sketch and show depths.

GROUND LEVEL

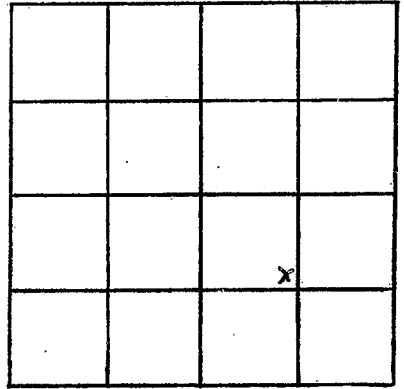

SECTION 32

Please indicate well location X.

ADDITIONAL INFORMATION

If more than one screen,
show locations of each on sketch.