

MISSISSIPPI DEPARTMENT OF NATURAL RESOURCES

Bureau of Land and Water Resources

BUD PENTON & SONS

Water Well Service

Rt. 4, Box 402  
Carriere, Mississippi 39209

Phone 601-798-5324

CODED

Pearl River  
1L135  
3/15/85

3/15 1985  
date well completed

firm name

Pearl River  
county well located

LANDOWNER: Derwood  
~~John~~ Sullivan  
PO Box 295 Carriere Miss  
(mailing address) 39426

description of formations encountered

from to

WELL LOCATION:  
sec. 10 T. 6 N R. 17 E  
7 miles W of Carriere  
(distance) (direction) (nearest town)

<u>white shale</u>	<u>0</u>	<u>12</u>
<u>white sand</u>	<u>12</u>	<u>45</u>
<u>blue shale</u>	<u>45</u>	<u>195</u>
<u>gray sand</u>	<u>195</u>	<u>267</u>
<u>blue shale</u>	<u>267</u>	<u>680</u>
<u>gray sand</u>	<u>280</u>	<u>735</u>
<u>blue shale</u>	<u>735</u>	<u>830</u>
<u>gray sand</u>	<u>850</u>	<u>925</u>

WELL PURPOSE: Drain  
(home, irrigation, municipal, industrial)

WELL COMPLETION DATA:

- (1) diameter (inches) 3"
- (2) total depth (feet) 925
- (3) static water level (feet) 20 ~~below~~ above top of ground.
- (4) casing galv. 925  
(material) (depth)  
20 if telescope see back.  
(size)
- (5) screen 20 905  
(length) (depth to top)  
12 Stone  
(size) (material)
- (6) pump 20  
(HP) (yield gpm)

(type power)  
(7) electric log no  
(yes or no)

(organization running log)

(8) how well bottom plugged and  
shale

RECEIVED


JUN 8 1985

Department of Natural Resources  
Bureau of Land & Water Resources

DRILLERS REMARKS:

If well telescopes please sketch and show depths.

GROUND LEVEL

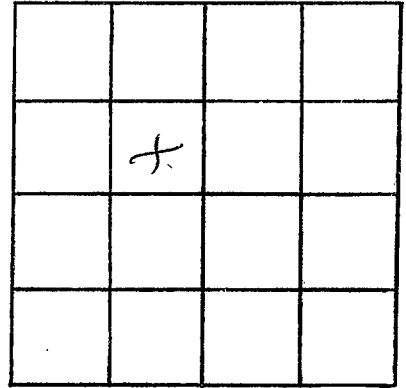

SECTION \_\_\_\_\_

Please indicate well location X.

ADDITIONAL INFORMATION

If more than one screen, show locations of each on sketch.