

PEARL RIVER
U 136

MISSISSIPPI DEPARTMENT OF NATURAL RESOURCES
Bureau of Land and Water Resources
Southport Mall
P.O. Box 10631
Jackson, Mississippi 39209
WATER WELL DRILLERS LOG

CODED

6-13 1985 PENTON WELL SERVICE PEARL RIVER
date well completed firm name county well located

LANDOWNER: NOLAN WISE
PICAYUNE, MS

(mailing address)

WELL LOCATION:
sec. 32 T 5 S R 17 W
2 miles W of PICAYUNE
(distance) (direction) (nearest town)

description of formations encountered	from	to
CLAY	0	50
SAND	50	85
CLAY	85	280
SAND	280	385
CLAY	385	500
SAND	500	585

CODED

WELL PURPOSE: HOME
(home, irrigation, municipal, industrial)

- WELL COMPLETION DATA:
- (1) diameter (inches) 2"
 - (2) total depth (feet) 585'
 - (3) static water level (feet) Flow above top of ground.
 - (4) casing PVC (material), 570' (depth)
2" (size) if telescope see back.
 - (5) screen 15' (length), 570' (depth to top)
2" (size), PVC (material)
 - (6) pump _____ (HP) _____ (yield gpm)
(type power)
 - (7) electric log NO (yes or no)
(organization running log)
 - (8) how well bottom plugged BW


RECEIVED
JUL 8 - 1985

DRILLERS REMARKS:

Department of Natural Resources
Bureau of Land & Water Resources

If well telescopes please sketch and show depths.

GROUND LEVEL

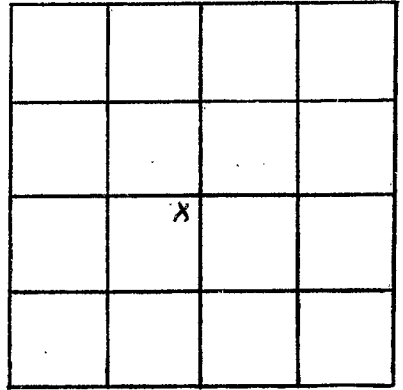

SECTION 32

Please indicate well location X.

ADDITIONAL INFORMATION

If more than one screen, show locations of each on sketch.