

Pearl R.

MISSISSIPPI BOARD OF WATER COMMISSIONERS

U 137

4-23-65

WATER WELL DRILLERS LOG

Date: 4-23, 1965, Driller: Walter Pantoni County Pearl River (Name)

(1) Owner of Land: Clay Whitfield
 (Name)
Picayune Miss
 (Address)

(2) Location: N-W 1/4, N-E 1/4, Sec. 16, 5, 17, R. 17
5 miles N-W, of Picayune
 (distance) (direction) (Nearest Town)

(3) Topography: Hilly
 (Hilly) (Flat) (Level)

(4) Purpose of Well: Domestic
 (Domestic Irrigation
 Municipal, Industrial, Other)

Description & Color of Materials Sand, Clay, Red Clay, Shell, etc.	Thick- ness Feet	Depth Feet
Mixed sand & clay	0	58
Yellow sand	40	98
Blue sandy clay	122	220
Blue sand	88	308
Blue clay	47	355
Grey sand	21	376
Blue clay	104	480
Mixed sand & clay	58	538
Grey sand	40	578
Blue clay	68	646
Grey sand	76	722
Blue clay	80	802
Grey sand		896

Information upon completion of well:

(1) Diameter 2 inches.

(2) Total Depth 896 feet.

(3) Water Level Flow feet below top of ground.

(4) Cased to _____, Size _____.

(5) Screen: Size .010, Length 15'.


(6) Were any formations sealed against pollution?
 _____ yes, _____ no.

If YES depth of formation _____
 Why _____

Drillers Remarks: 8 lbs Pressure
Shut in at ground
level

Rock Ranch Rd.
Little flow
new owner

$$\begin{array}{r} 896 \\ - 15 \\ \hline 881 \end{array}$$

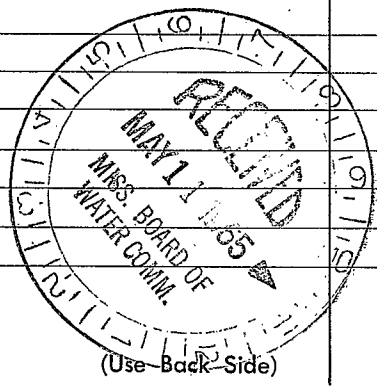

Well No.

