

Pearl River
71 139
8/13/76

MISSISSIPPI
 BOARD OF WATER COMMISSIONERS
 416 North State Street
 Jackson, Mississippi 39201

13V

WATER WELL DRILLERS LOG

8-13 1976 Bud Center + Son Pearl River
 date well completed firm name county well located

LANDOWNER: J. Bertrand

description of formations encountered

from to

Route 9,
Carriere, Ms.
 (mailing address)

<u>red shale</u>	<u>0</u>	<u>26</u>
<u>white sand</u>	<u>26</u>	<u>35</u>
<u>blue shale</u>	<u>35</u>	<u>105</u>
<u>blue sand</u>	<u>105</u>	<u>135</u>
<u>blue shale</u>	<u>135</u>	<u>285</u>
<u>blue sand</u>	<u>285</u>	<u>365</u>
<u>blue shale</u>	<u>365</u>	<u>500</u>
<u>blue sand</u>	<u>500</u>	<u>601</u>
<u>blue shale</u>	<u>601</u>	<u>780</u>
<u>blue sand</u>	<u>780</u>	<u>861</u>

WELL LOCATION:

sec. 9 T. 17 N. R. 15 E
2 1/2 miles West of Carriere
 (distance) (direction) (nearest town)

WELL PURPOSE: Home
 (home, irrigation, municipal, industrial)

WELL COMPLETION DATA:

- (1) diameter (inches) 2 in
- (2) total depth (feet) 861
- (3) static water level (feet) 100 below top of ground.
- (4) casing Galv. 841
 (material) (depth)
- _____ if telescope see back.
 (size)
- (5) screen 2 x 20 841
 (length) (depth to top)
- _____ 8. Steel
 (size) (material)
- (6) pump _____ (HP) _____ (yield gpm)
- _____ (type power)
- (7) electric log NO
 (yes or no)
- _____ (organization running log)
- (8) how well bottom plugged Sand Shave


DRILLERS REMARKS:

RECEIVED
 SEP - 2 1976

MISS. BD. OF WATER COMMISSIONERS

If well telescopes please sketch and show depths.

GROUND LEVEL

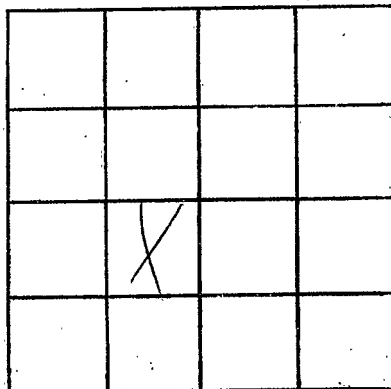

SECTION _____

Please indicate well location X.

ADDITIONAL INFORMATION

If more than one screen, show locations of each on sketch.