

Pearl River  
U 141  
9-29-77

MISSISSIPPI  
 BOARD OF WATER COMMISSIONERS  
 416 North State Street  
 Jackson, Mississippi 39201

WATER WELL DRILLERS LOG

9-29-77 date well completed      1977 firm name Stockstill Bros., Inc.      Pearl River county well located

LANDOWNER: Mr. Otis McNeese  
Pearl River, Miss  
 (mailing address)

WELL LOCATION:  
 sec. 20 T 5 N 5 R 17 E  
5 miles NW of Pearl River  
 (distance) (direction) (nearest town)

WELL PURPOSE: Home  
 (home, irrigation, municipal, industrial)

- WELL COMPLETION DATA:
- (1) diameter (inches) 2"
  - (2) total depth (feet) 365
  - (3) static water level (feet) 6" below top of ground.
  - (4) casing Gal. 345'  
 (material) (depth)  
2" If telescope see back.  
 (size)
  - (5) screen 20' 345'  
 (length) (depth to top)  
2" Stainless Steel  
 (size) (material)
  - (6) pump N= 45  
 (HP) (yield gpm)  
No  
 (type power)
  - (7) electric log No  
 (yes or no)  
No  
 (organization running log)
  - (8) how well bottom plugged Sand & silt

description of formations encountered	from	to
Clay	0	15
Sand	15	40
Clay	40	110
Sand	110	150
Clay	150	210
Sand	210	315
Clay	315	460
Sand	460	620
Clay	620	835
Sand	835	965

DRILLERS REMARKS:


**RECEIVED**

OCT 11 1977  
 OCT 11 1977

MISS. BD. OF WATER COMM.

If well telescopes please sketch and show depths.

GROUND LEVEL

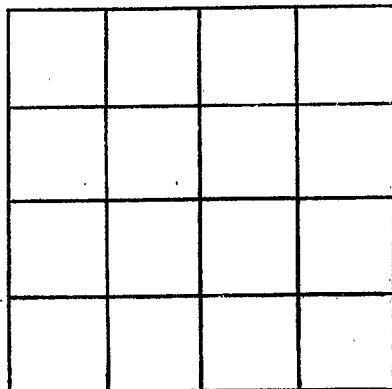

SECTION \_\_\_\_\_

Please indicate well location X.

ADDITIONAL INFORMATION

If more than one screen, show locations of each on sketch.