

PEARL RIVER
 U 143
 04-06-79

MISSISSIPPI
 BOARD OF WATER COMMISSIONERS
 416 North State Street
 Jackson, Mississippi 39201

WATER WELL DRILLERS LOG

4-6 1979 Penton well Serv Pearl River
 date well completed firm name county well located

LANDOWNER: <u>Allen Bickerton</u> <u>Rt.</u>	description of formations encountered	from	to
		0	10
PEACYPINE MS. (mailing address)	Sand	10	60
	Blue Clay	60	260
	Sand	260	400
	Blue Clay	400	680
	Sand	680	750
	Blue Clay	750	990
WELL LOCATION: sec. <u>5</u> T <u>5</u> R <u>17</u> S W	Sand	990	1040
3 miles <u>NW</u> of <u>Peaypine</u> (distance) (direction) (nearest town)			

WELL PURPOSE: Home
 (home, irrigation, municipal, industrial)

WELL COMPLETION DATA:

(1) diameter (inches) 2

(2) total depth (feet) 1040

(3) static water level (feet) Flow ^{below} above top of ground.

(4) casing Galv 1020
 (material) (depth)

2
 (size) if telescope see back.

(5) screen 20' 1020
 (length) (depth to top)

2 St Steel
 (size) (material)

(6) pump 30
 (HP) (yield gpm)

—
 (type power)

(7) electric log No
 (yes or no)

—
 (organization running log)

(8) how well bottom plugged BW Value

Flows

DRILLERS REMARKS:


Miss. Board of Water Comm.

MAY - 7 1979

RECEIVED

If well telescopes please sketch and show depths.

GROUND LEVEL

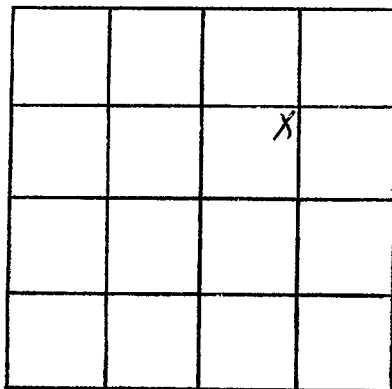

SECTION 31

Please indicate well location X.

ADDITIONAL INFORMATION

Lined area for additional information.

If more than one screen, show locations of each on sketch.