

PEARL RIVER  
U 144  
04-14-79

MISSISSIPPI  
BOARD OF WATER COMMISSIONERS  
416 North State Street  
Jackson, Mississippi 39201

WATER WELL DRILLERS LOG

4-14-79 Pentons Well Serv Pearl River  
date well completed firm name county well located

LANDOWNER: Wilmar McQueen  
RT-  
Picayune, MS  
(mailing address)

WELL LOCATION:  
sec. 19 T 5 S R 12 E W  
4 miles NW of Picayune  
(distance) (direction) (nearest town)

WELL PURPOSE: Home  
(home, irrigation, municipal, industrial)

WELL COMPLETION DATA:

(1) diameter (inches) 2  
(2) total depth (feet) 1050  
(3) static water level (feet) How <sup>below</sup> above top of ground.  
(4) casing Galv 1030 (material) (depth)  
2 (size) if telescope see back.  
(5) screen 20' 1030 (length) (depth to top)  
2" S. Steel (size) (material)  
(6) pump 20 (HP) (yield gpm)  
(type power)  
(7) electric log NO (yes or no)  
(organization running log)  
(8) how well bottom plugged BW Galv

description of formations encountered	from	to
Surface clay	0	15
Sand	15	30
Blue clay	30	200
Sand	200	360
Blue clay	360	460
Sand	460	540
Blue clay	540	660
Sand	660	720
Blue clay	720	960
Sand	960	1050

pump on well

DRILLERS REMARKS:


Miss. Board of Water Comm.

MAY - 7 1979

RECEIVED

If well telescopes please sketch and show depths.

GROUND LEVEL

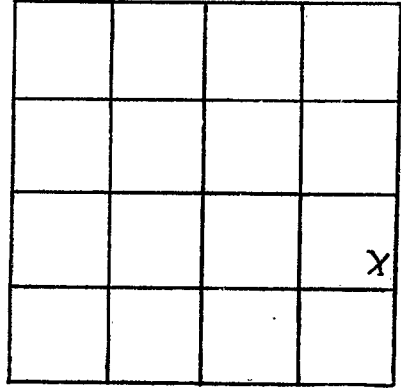

SECTION 19

Please indicate well location X.

ADDITIONAL INFORMATION

A series of horizontal lines for recording additional information.

If more than one screen, show locations of each on sketch.