

Pearl Rv  
 U 146  
 6-10-81

MISSISSIPPI  
 BOARD OF WATER COMMISSIONERS  
 416 North State Street  
 Jackson, Mississippi 39201

WATER WELL DRILLERS LOG

6-10-1981 date well completed  
 81 Penton Well Seed firm name  
 Pearl River county well located

LANDOWNER: J.E. Mitchell  
 Rt. 2 Ernest  
 Carriere, Ms.  
 (mailing address)


WELL LOCATION:  
 OK (34) sec 5 T 5 R 17 E  
 S W  
 1 1/2 miles N. of Pazyune  
 (distance) (direction) (nearest town)

WELL PURPOSE: Home  
 (home, irrigation, municipal, industrial)

WELL COMPLETION DATA:

(1) diameter (inches) 2  
 (2) total depth (feet) 980  
 (3) static water level (feet) Flow below top of ground.  
 (4) casing Black, 960  
 (material) (depth)  
 2 If telescope see back.  
 (size)  
 (5) screen 30', 960  
 (length) (depth to top)  
 2, S. Steel  
 (size) (material)  
 (6) pump L 20  
 (HP) (yield gpm)  
 (type power)  
 (7) electric log NO  
 (yes or no)  
 (organization running log)  
 (8) how well bottom plugged B.W. Deloo

description of formations encountered	from	to
Surface Clay	0	15
Sand	15	30
Blue Clay	30	260
Sand	260	360
Clay	360	460
Sand	460	510
Clay	510	550
Sand	550	630
Clay	630	865
Sand	865	980

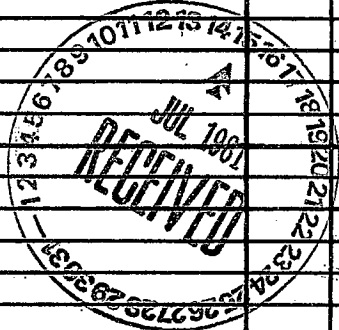

DRILLERS REMARKS:

If well telescopes please sketch and show depths.

GROUND LEVEL

	X		

SECTION 36

Please indicate well location X.

ADDITIONAL INFORMATION

If more than one screen, show locations of each on sketch.