

MISSISSIPPI DEPARTMENT OF NATURAL RESOURCES

Bureau of Land and Water Resources

Southport Mall

P.O. Box 10631

BUD PENTON & SONS

WATER WELL DRILLERS LOG

Rt. 4, Box 402

Carriere, Mississippi 39426

Phone 601 - 798-5324

county well located

Pearl River
W. 147

8/19

1986

date well completed

Pearl River

LANDOWNER: Ann Smith
R.T. 6 Box 119, Picayune
Miss
(mailing address)

WELL LOCATION:
sec. 29 T. 5 N R. 57 E
S W
2 miles North of picayune
(distance) (direction) (nearest town)

WELL PURPOSE: Home
(home, irrigation, municipal, industrial)

WELL COMPLETION DATA:

- (1) diameter (inches) 2"
- (2) total depth (feet) 570
- (3) static water level (feet) 6' 6" below above top of ground.
- (4) casing pvc 59 14'
(material) (depth)
- if telescope see back.
(size)
- (5) screen 2x15 526
(length) (depth to top)
- 1 1/2 pvc
(size) (material)
- (6) pump 700
(HP) (yield gpm)
- (type power)
- (7) electric log no
(yes or no)
- (organization running log)
- (8) how well bottom plugged sand
mark

description of formations encountered	from	to
<u>B. red shale</u>	<u>0</u>	<u>21</u>
<u>white sand</u>	<u>21</u>	<u>60</u>
<u>blue shale</u>	<u>60</u>	<u>300</u>
<u>gray sand</u>	<u>300</u>	<u>385</u>
<u>blue shale</u>	<u>385</u>	<u>570</u>
<u>gray sand</u>	<u>570</u>	<u>579</u>

BUD PENTON & SONS
Water Well Service
Rt. 4, Box 402
Carriere, Mississippi 39426
Phone 601 - 798-5324

RECEIVED


APR 21 1987

Department of Natural Resources
Bureau of Land & Water Resources

DRILLERS REMARKS:

If well telescopes please sketch and show depths.

GROUND LEVEL

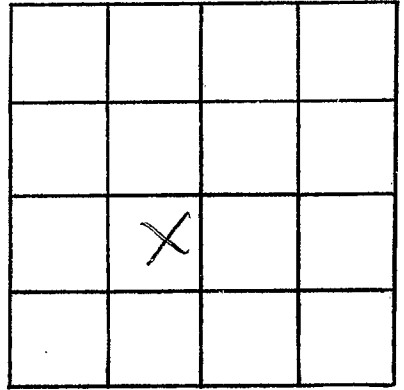

SECTION _____

Please indicate well location X.

ADDITIONAL INFORMATION

If more than one screen, show locations of each on sketch.