

MISSISSIPPI DEPARTMENT OF NATURAL RESOURCES

Bureau of Land and Water Resources

Southport Mall

P.O. Box 10631

Jackson, Mississippi 39209

159 WATER WELL DRILLERS LOG

CODED

Pearl River  
U 148

11/7/84 date well completed 1984 Budington water well name Pearl River county well located

LANDOWNER: Mr. Jeff

description of formations encountered	from	to
<u>White shale</u>	<u>0</u>	<u>21</u>
<u>yellow sandstone</u>	<u>21</u>	<u>63</u>
<u>blue shale</u>	<u>63</u>	<u>275</u>
<u>blue sand</u>	<u>275</u>	<u>315</u>
<u>blue shale</u>	<u>315</u>	<u>515</u>
<u>gray sand</u>	<u>515</u>	<u>573</u>

AJ-3 Pucayon

(mailing address)

WELL LOCATION:

sec. 21 T. 5 N. R. 17 E. S. W.  
4 miles W of Pucayon  
(distance) (direction) (nearest town)

WELL PURPOSE: home  
(home, irrigation, municipal, industrial)

CODED

WELL COMPLETION DATA:

- (1) diameter (inches) 2"
- (2) total depth (feet) 573
- (3) static water level (feet) 10 below/above top of ground.
- (4) casing PVC (material), 573 (depth)

\_\_\_\_\_ if telescope see back.  
(size)

- (5) screen 2x20 (length), 553 (depth to top)

10 (size), PVC (material)

- (6) pump \_\_\_\_\_ (HP) \_\_\_\_\_ (yield gpm)

\_\_\_\_\_ (type power)

- (7) electric log NO (yes or no)

\_\_\_\_\_ (organization running log)

- (8) how well bottom plugged Sand  
Shark


DRILLERS REMARKS: NO Pump  
provided

DEPT. OF NATURAL RESOURCES  
BUREAU OF LAND & WATER RESOURCES

DEC-4 1984  
RECEIVED

If well telescopes please sketch and show depths.

GROUND LEVEL

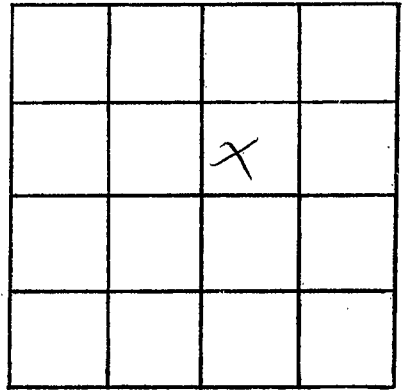

SECTION \_\_\_\_\_

Please indicate well location X.

ADDITIONAL INFORMATION

If more than one screen,  
show locations of each on sketch.