

MISSISSIPPI DEPARTMENT OF NATURAL RESOURCES

Bureau of Land and Water Resources

Southport Mall

P.O. Box 10631

BUD PENTON & SON
WATER WELL SERVICE
ROUTE 501
CARRIERS JACKSON, Mississippi 39209
PHON: WATER WELL DRILLERS LOG

CODED

Pearl River
U 149

8/15 1984
date well completed

Pearl River
county well located

LANDOWNER: Connie Smith

description of formations encountered	from	to
<u>White shale</u>	<u>0</u>	<u>40</u>
<u>White sand</u>	<u>40</u>	<u>70</u>
<u>Blue shale</u>	<u>70</u>	<u>218</u>
<u>Blue sand</u>	<u>218</u>	<u>270</u>
<u>Blue shale</u>	<u>270</u>	<u>620</u>
<u>Gray sand</u>	<u>620</u>	<u>670</u>

PO Box 1031
Picayune Miss
(mailing address)

WELL LOCATION:

sec 21 T 5 N R 17 E
626 miles W of Picayune
(distance) (direction) (nearest town)

WELL PURPOSE: home
(home, irrigation, municipal, industrial)

WELL COMPLETION DATA:

- (1) diameter (inches) 2"
- (2) total depth (feet) 670 ft
- (3) static water level (feet) 8 1/2 below top of ground.
- (4) casing PVC, 670,
(material) (depth)
if telescope see back.
(size)
- (5) screen 2x20, 650
(length) (depth to top)
10, PVC
(size) (material)
- (6) pump no
(HP) (yield gpm)
no
(type power)
- (7) electric log no
(yes or no)

(organization running log)

(8) how well bottom plugged stayed sharp

DRILLERS REMARKS:

CODED


DEPT. OF NATURAL RESOURCES
BUREAU OF LAND & WATER RESOURCES

DEC - 4 1984

RECEIVED

If well telescopes please sketch and show depths.

GROUND LEVEL

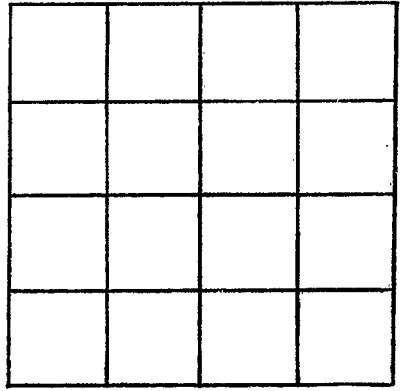

SECTION _____

Please indicate well location X.

ADDITIONAL INFORMATION

A series of 20 horizontal lines for providing additional information.

If more than one screen, show locations of each on sketch.