

MISSISSIPPI DEPARTMENT OF NATURAL RESOURCES

Bureau of Land and Water Resources

Southport Mall

P.O. Box 10631

Jackson, Mississippi 39209

WATER WELL DRILLERS LOG

CODED

Pearl River
~~U~~ U 150

12-27

1984 PENTON WELL SERV

PEARL RIVER

date well completed

firm name

county well located

LANDOWNER: Allen Richardson

description of formations encountered

from

to

Rt. Picayune
 (mailing address)

SURFACE CLAY
 SAND
 BLUE CLAY
 SAND
 BLUE CLAY
 SAND

0	50
50	75
75	300
300	330
330	460
460	570

WELL LOCATION:

sec. 29 T. 5 S. R. 17 W.
3 miles NW of Picayune
 (distance) (direction) (nearest town)

WELL PURPOSE: HOME
 (home, irrigation, municipal, industrial)

WELL COMPLETION DATA:

- (1) diameter (inches) 2
- (2) total depth (feet) 570'
- (3) static water level (feet) Flw 560' below above top of ground.
- (4) casing PVC 560'
 (material) (depth)
- 2 if telescope see back.
 (size)
- (5) screen 10' 560'
 (length) (depth to top)
- 2 PVC
 (size) (material)
- (6) pump 1/2
 (HP) (yield gpm)
- Elec
 (type power)
- (7) electric log NO
 (yes or no)

(organization running log)

(8) how well bottom plugged BW

CODED

RECEIVED


JAN 24 1985

Department of Natural Resources
 Bureau of Land & Water Resources

DRILLERS REMARKS:

If well telescopes please
sketch and show depths.

GROUND LEVEL

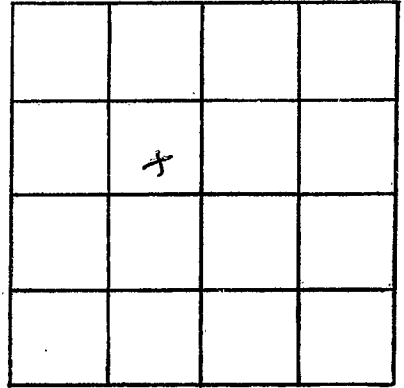

SECTION 29

Please indicate well location X.

ADDITIONAL INFORMATION

If more than one screen,
show locations of each on sketch.