

MISSISSIPPI DEPARTMENT OF NATURAL RESOURCES

Bureau of Land and Water Resources

BUD PENTON & SONS

Water Well Service

Rt. 4, Box 10631

Carriere, Mississippi 39209

Phone 601-799-5321

WATER WELL DRILLERS LOG

CODED

Pearl River  
 U 151  
 3/22/85

3/22 1985  
 date well completed

firm name

Pearl River  
 county well located

LANDOWNER: Jim Fornes  
 Rt. 6 Box 68 Piquette  
 Mo 39426  
 (mailing address)

description of formations encountered

from to

Red shale	0	20
White sand	20	60
Blue shale	60	300
Gray sand	300	355
Blue shale	355	600
Gray sand	600	637

WELL LOCATION:

sec. 28 T. 5 N. R. 17 E.  
 1/4 miles NW of Piquette  
 (distance) (direction) (nearest town)

WELL PURPOSE: Home  
 (home, irrigation, municipal, industrial)

WELL COMPLETION DATA:

- (1) diameter (inches) 2"
- (2) total depth (feet) 637
- (3) static water level (feet) 8 below above top of ground.
- (4) casing PVC 637, (material) (depth)
- (size) if telescope see back.
- (5) screen 20 617 (length) (depth to top)
- (size) PVC (material)
- (6) pump 1/2 (HP) 450 2.5 (yield gpm) 9 gpm
- (type power) Elect
- (7) electric log no (yes or no)

(organization running log)

(8) how well bottom plugged Sand  
 Shale

DRILLERS REMARKS:

CODED


RECEIVED

JUN - 6 1985

Department of Natural Resources  
 Bureau of Land & Water Resources

If well telescopes please  
sketch and show depths.

GROUND LEVEL

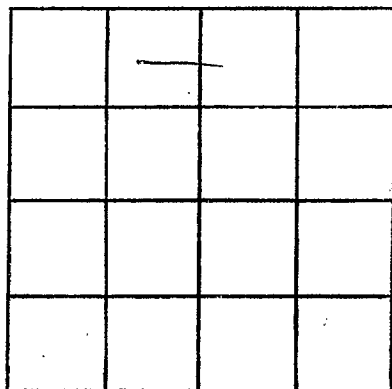

SECTION \_\_\_\_\_

Please indicate well location X.

ADDITIONAL INFORMATION

If more than one screen,  
show locations of each on sketch.