

SW of Pump

Pearl River
U. 55
7/22/80

MISSISSIPPI
BOARD OF WATER COMMISSIONERS
416 North State Street
Jackson, Mississippi 39201

CODED

WATER WELL DRILLERS LOG

7/22/80 19 Lyman Well Co. Pearl River
date well completed firm name county well located

LANDOWNER: Kenneth Patterson
Rt 2
Picayune, Miss
(mailing address)

description of formations encountered	from	to
Red clay	0	10
Red or white	10	18
Sand & gravel	18	15
Grey clay	115	210
Grey sand shale	210	290
Blue clay	290	520
Sand gravel	520	622

WELL LOCATION:
sec. 28 T. 5 N R. 17 E
1 miles (distance) S of Picayune (direction) (nearest town)

WELL PURPOSE: Home
(home, irrigation, municipal, industrial)

WELL COMPLETION DATA:

(1) diameter (inches) 2"

(2) total depth (feet) 622'

(3) static water level (feet) 13 ^{below} ~~above~~ top of ground.

(4) casing PVC 602'
(material) (depth)
2" (size) if telescope see back.

(5) screen 20' 602'
(length) (depth to top)
6 slot PVC
(size) (material)

(6) pump (HP) (yield gpm)
(type power)

(7) electric log NO
(yes or no)

(organization running log)

(8) how well bottom plugged Sand
Shark

DRILLERS REMARKS:
good flow


DEPT. OF NATURAL RESOURCES
BUREAU OF LAND & WATER RESOURCES

NOV 6 1980

RECEIVED

If well telescopes please sketch and show depths.

GROUND LEVEL

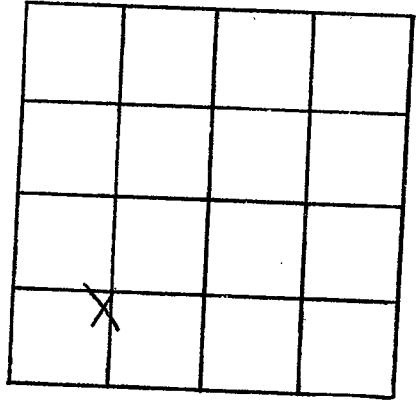

SECTION 28

Please indicate well location X.

ADDITIONAL INFORMATION

Lined area for additional information.

If more than one screen, show locations of each on sketch.