

MISSISSIPPI DEPARTMENT OF NATURAL RESOURCES

Bureau of Land and Water Resources

Southport Mall

P.O. Box 10631

Jackson, Mississippi 39209

WATER WELL DRILLERS LOG

CODED

Pear River  
U-156  
7-14-83

03180004

Penton + Son 309  
 firm name

Pear River  
 county well located

7/14 1983  
 date well completed

LANDOWNER: B & Shippers  
B.T. & Bob Picayune  
Miss.  
 (mailing address)

description of formations encountered	from	to
<u>white shaley</u>	<u>0</u>	<u>35</u>
<u>white sand</u>	<u>35</u>	<u>70</u>
<u>blue shale</u>	<u>70</u>	<u>510</u>
<u>gray sand</u>	<u>570</u>	<u>567</u>

WELL LOCATION:  
 sec. 28 T. 5 N. R. 17 E.  
4 miles NW of Picayune  
 (distance) (direction) (nearest town)

WELL PURPOSE: home  
 (home, irrigation, municipal, industrial)

WELL COMPLETION DATA:

- (1) diameter (inches) 2"
- (2) total depth (feet) 567
- (3) static water level (feet) 8' below top of ground. 18' above
- (4) casing PVC, 567  
 (material) (depth)
- \_\_\_\_\_ if telescope see back.  
 (size)
- (5) screen 2x50, 547  
 (length) (depth to top)
- 12, PVC  
 (size) (material)
- (6) pump \_\_\_\_\_  
 (HP) (yield gpm)
- \_\_\_\_\_ (type power)
- (7) electric log no  
 (yes or no)

\_\_\_\_\_ (organization running log)

(8) how well bottom plugged Shank

DRILLERS REMARKS: No pump furnished

CODED


DEPT. OF NATURAL RESOURCES  
 BUREAU OF LAND & WATER RESOURCES

NOV 18 1983

RECEIVED

If well telescopes please sketch and show depths.

GROUND LEVEL

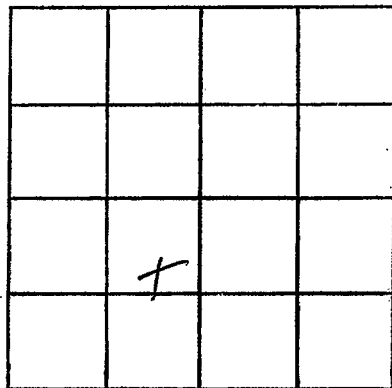

SECTION \_\_\_\_\_

Please indicate well location X.

ADDITIONAL INFORMATION

If more than one screen,  
show locations of each on sketch.