

FEB-20-2007 12:08P FROM:

TO:16013600535

P:1

### State Well Report

#### Part 1

Mississippi Department of Environmental Quality  
 Office of Land and Water Resources  
 P.O. Box 10631  
 Jackson, MS 39289-0631  
 (601)961-5210  
 (601)334-6938 (fax)

#### For Office Use Only:

Aquifer: \_\_\_\_\_  
 Well #: U-172  
 L. S. Elevation: \_\_\_\_\_  
 E-log #: \_\_\_\_\_

County: Pearl River  
 Permit #: \_\_\_\_\_  
 Driller: Travis Boone  
 Date drilling completed: 1-22-07

State Law requires that this report be prepared by the driller in detail and filed with the Department within 30 days of completion of drilling of the well.

Well Owner Information	Well Location
Owner Name: <u>Campbell-Boone</u>	Latitude: _____ Longitude: _____
Mailing Address: <u>108 Williamsburg Rd</u> <u>Picayune Ms</u> <u>39466</u>	Method of Lat/Long (circle one): Conventional Survey, USGS quad, Hand-held GPS, Survey-grade GPS
City: _____ State: _____ Zip Code: _____	_____ N _____ W Sec <u>80</u> Twn <u>55</u> Rng <u>17W</u>
Telephone No. (_____) _____	Distance _____ Miles Direction <u>NW</u> of Nearest Town <u>Picayune</u>

**Well Data**

Purpose of Well (circle one) Home Industrial Public Supply Irrigation Fish Culture Other: \_\_\_\_\_

Date well drilling started: 1-22-07 Date well drilling completed: 1-22-07

If flowing, method of flow regulation: Valve \_\_\_\_\_ Other (describe) \_\_\_\_\_

Static Water Level: 6 feet above or below (circle one) land surface Date measured: 1-22-07

Method of Measurement (circle one) steel tape electric tape air line other: StringLine

Hole depth: \_\_\_\_\_ Well depth: 90 Well grouted to a depth of 10 feet

Type of grout (circle one): Cement Bentonite Mix

Casing length: 60 feet Casing diameter: 4 inches Type of casing: Sch 40

Screen length: 30 feet Screen diameter: 4 inches Type of screen: Sch 40 wrapped

Screen slot size: 8 inches Setting depth: From 60 feet to 90 feet

Type of completion (circle all applicable): Gravel packed Undersampled Telescoped Open hole Natural Development  
 Other (describe): \_\_\_\_\_

Top of lap pipe or reduction in casing: \_\_\_\_\_ feet. If telescoped or more than one screen, describe on back of page

Logs run (circle all applicable): No log run Electric Gamma Ray Density Sonic Neutron Other: \_\_\_\_\_

Name of organization running log(s): \_\_\_\_\_

I certify that the well was drilled, constructed, and completed in accordance with all applicable requirements of the Mississippi Department of Environmental Quality and/or the Mississippi Department of Health regulations and state laws.

Travis Boone 0-514  
 Print Name of Water Well Contractor and License No.

Travis Boone  
 Signature of Water Well Contractor

RECEIVED  
 FEB 20 2007  
 BY: OLWR

FEB-20-2007 12:09P FROM:


TD:16013600535

P:3

U-172

If well telescopes please sketch below and show depths.

Ground Level

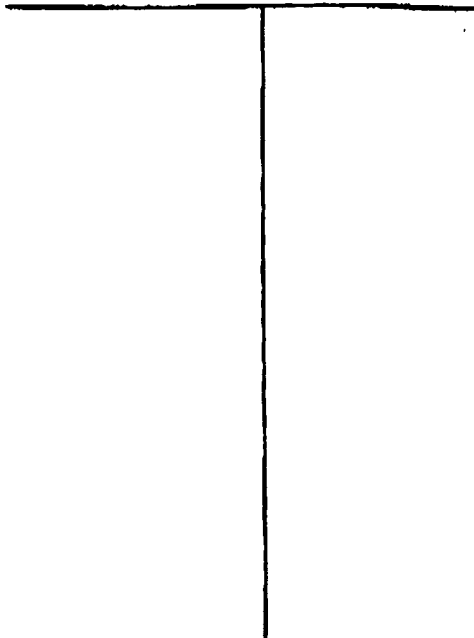

Description of Formations Encountered

From To

Description of Formations Encountered	From	To
Clay	2	5
sand + porous gravel	5	90

If more than one screen, show location of each on sketch

Sketch the property layout and include the following: 1) the well location; 2) any permanent structures on the property that may aid in locating the well; 3) any roads, power lines, or other items that may aid in locating the property and the well; 4) indicate direction.

Landowner Name: Bruce Campbell

[Signature]  
Signature of Water Well Contractor

RECEIVED  
FEB 20 2007  
BY: OLWR

FEB-20-2007 12:08P FROM:

TO: 16013600535

P:2

# STATE WELL REPORT

## Part 2

**Pump Installer's Completion Report**  
 Mississippi Department of Environmental Quality  
 Office of Land and Water Resources  
 P.O. Box 10631  
 Jackson, MS 39289-0631  
 (601)961-5210  
 (601)354-6938 (fax)

County: Pond River  
 Permit #: \_\_\_\_\_  
 Driller: Travis Boone  
 Date completed: 1-22-07

**For Office Use Only:**  
 Aquifer: \_\_\_\_\_  
 Well #: U-172  
 Elevation: \_\_\_\_\_

This report should be prepared by the pump installer in detail and filed with the Department within 30 days of the installation of pump.

Well Owner Information	Well Location
Owner Name: <u>Bruce Campbell</u>	Latitude: _____ Longitude: _____
Mailing Address: <u>108 Williamsburg Rd.</u> <u>Picayune, MS</u>	Method of Lat/Long (circle one): <u>Conventional Survey</u>
<u>39464</u> City State Zip Code	USGS quad, Hand-held GPS, Survey-grade GPS
Telephone No. ( ) _____	_____ 4 _____ 4 Sec. <u>80</u> Twp. <u>5S</u> Rng. <u>17W</u>
	Distance Direction Nearest Town
	<u>3</u> Miles <u>NW</u> of <u>Picayune</u>

Pump Type Circle one	Power Type Circle one
Air Lift Jet <u>Submersible</u>	Diesel Engine Gasoline Engine Natural Gas
Bucket Plunger Turbine	<u>Electric Motor</u> Hand Tractor PTO
Centrifugal Rotary Flowing Well	Windmill Other (specify): _____
Other (specify): _____	Horse Power Rating of Motor: <u>5</u>
Date Pump Installed: <u>1-22-07</u>	Setting Depth: <u>6.5</u> feet
Rated Pump Capacity: <u>8.5</u> Gallons Per Minute	Number of Stages: _____

Pump Test Data	Method of Measuring Water Level Circle one
Date Well Tested: <u>1-22-07</u>	Air Line Electric Measuring Line Steel Tape
Static Water Level (A): <u>6</u> Feet Below Land Surface	Other (specify): <u>String Line</u>
Pumping Water Level (B): _____ Feet Below Land Surface	For flowing well, measured start in bore: _____ feet
Drawdown (B) - (A): _____ Feet Below Land Surface	Well yielded _____ GPM with a drawdown of _____ feet after _____ hours of pumping
Test Pumping Rate: <u>100 OE</u> Gallons Per Minute	
Duration of Pump Test (minimum 4 hours): _____ hour	

I HEREBY CERTIFY that the above statements are true to the best of my knowledge.

Travis Boone  
 Print Name of Pump Installer and License No. (if applicable)

Travis Boone  
 Signature of Pump Installer

RECEIVED  
 FEB 20 2007  
 BY: OLWF