

Pearl R.  
U2000

MISSISSIPPI BOARD OF WATER COMMISSIONERS

WATER WELL DRILLERS LOG

1-9-62

Date: Jan, 9, 1962, Driller: M&B Drilling Co. County Pearl River

(1) Owner of Land: Wood O. Quinn  
(Name)  
R.R. Carrier, Miss  
(Address)

(2) Location: NW 1/4, SE 1/4, Sec. 11 T. 5R17  
1 1/2 miles West of Carrier  
(distance) (direction) (Nearest Town)

(3) Topography: Hilly  
(Hilly) (Flat) (Level)

(4) Purpose of Well: Domestic  
(Domestic Irrigation Municipal, Industrial, Other)

Description & Color of Materials Sand, Clay, Red Clay, Shell, etc.	Thick- ness Feet	Depth Feet
Brown Clay	20	20
Fine White Sand	20	40
Coarse " "	20	60
Hard White Clay	40	100
Blue Clay	10	110
Sand & Clay Breaks	13	123
Hard Blue Clay	22	145
Sand & Clay Breaks	40	185
<del>White Sand</del>		
White Clay & Brownish Sand	21	206
Hard Blue Clay		
Fine Grey Saffee Peppin		
Sand	14	220
Coarser Sand	20	240
Very Coarse Sand		270
Was still cutting		
Coarse Grey Sand with		
" Black Rock mixed		
when we quit cutting		
hole.		

Information upon completion of well:

(1) Diameter 2 inches.

(2) Total Depth 262 feet.

(3) Water Level 70 feet below top of ground.

(4) Cased to 252, Size 2"


(5) Screen: Size 2"-8 5/16", Length 10 FT.

(6) Were any formations sealed against pollution?  
 \_\_\_\_\_ yes, \_\_\_\_\_ no.

If YES depth of formation \_\_\_\_\_

Why \_\_\_\_\_

Drillers Remarks: \_\_\_\_\_

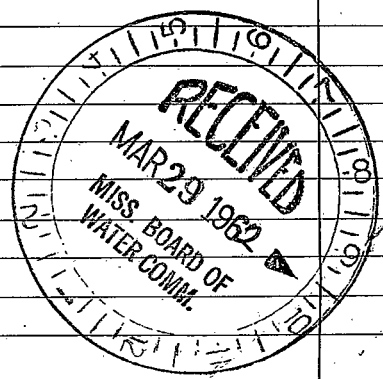

(Use Back Side)

Well No.

*[The page contains extremely faint, illegible text, likely bleed-through from the reverse side of the document. The text is scattered across the page and cannot be transcribed.]*