

Pearl R.  
U2002  
4-25-64

MISSISSIPPI BOARD OF WATER COMMISSIONERS

WATER WELL DRILLERS LOG

Date: 4-25, 1964, Driller: Walter County Pearl River  
(Name)

(1) Owner of Land: Claude Whitfield  
(Name)

Picayune Miss  
(Address)

Description & Color of Materials  
Sand, Clay, Red Clay, Shell, etc.

yellow clay  
white sand &  
Gravel

Thick-  
ness  
Feet

Depth  
Feet

0 to 12  
46 58

(2) Location N-W 1/4, S-E 1/4, Sec. 16 T. 51 R. 17

4 1/2 miles N.W., of Picayune  
(distance) (direction) (Nearest Town)

(3) Topography: Flat  
(Hilly) (Flat) (Level)

(4) Purpose of Well: Domestic  
(Domestic Irrigation  
Municipal, Industrial, Other)


Information upon completion of well:

- (1) Diameter 2" inches.
- (2) Total Depth 58 feet.
- (3) Water Level 19 feet below top of ground.
- (4) Cased to \_\_\_\_\_, Size \_\_\_\_\_.
- (5) Screen: Size \_\_\_\_\_, Length 6'
- (6) Were any formations sealed against pollution?  
\_\_\_\_\_ yes, \_\_\_\_\_ no.

If YES depth of formation \_\_\_\_\_

Why \_\_\_\_\_

Drillers Remarks: \_\_\_\_\_

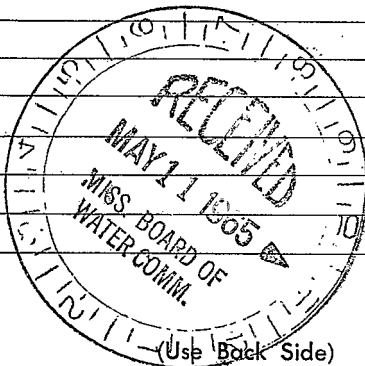

Well No.

