

Pearl River  
 U2007  
 11-67

MISSISSIPPI  
 BOARD OF WATER COMMISSIONERS  
 416 North State Street  
 Jackson, Mississippi 39201

WATER WELL DRILLERS LOG

11-16 date well completed  
 1967 Penton Well Serv firm name  
 Pearl River county well located

LANDOWNER: Mrs. May Knoblock

description of formations encountered

from to

Rh 2 Box 66

Clay

0 14

Carriere MISS  
 (mailing address)

Red Sand

14 22

White Sand

22 46

WELL LOCATION:

sec. 25 T. 5 S. R. 17 W.  
 1 miles South of Oxona  
 (distance) (direction) (nearest town)

WELL PURPOSE: Home  
 (home, irrigation, municipal, industrial)

WELL COMPLETION DATA:

(1) diameter (inches) 4 1/2"

(2) total depth (feet) 46

(3) static water level (feet) 22 below top of ground.

(4) casing PVC, 40' (material), (depth)

2" if telescope see back. (size)

(5) screen 6', 40' (length), (depth to top)

.014 2", PVC (size), (material)

(6) pump 1/2 HP, 6 (yield gpm)


Elec (type power)

(7) electric log NO (yes or no)

(organization running log)


(8) how well bottom plugged BW Valve

DRILLERS REMARKS:

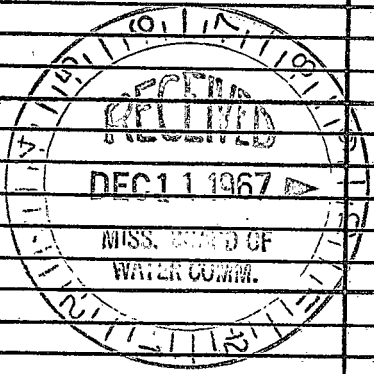

If well telescopes please sketch and show depths.

GROUND LEVEL

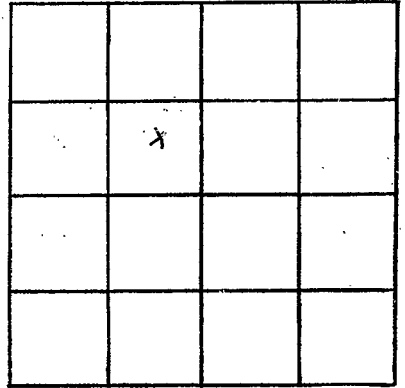

SECTION 25

Please indicate well location X.

ADDITIONAL INFORMATION

If more than one screen, show locations of each on sketch.