

Pearl River  
U 2008  
1-68

MISSISSIPPI  
 BOARD OF WATER COMMISSIONERS  
 416 North State Street  
 Jackson, Mississippi 39201

WATER WELL DRILLERS LOG

1-30 1968 Ponton Well Serv Pearl River  
 date well completed firm name county well located

LANDOWNER: Col. Frank Spiess

Jackson Barracks

New Orleans La.  
 (mailing address)

WELL LOCATION:

sec. 5 T. 5 S. R. 17 W.  
4 miles West of Carriere  
 (distance) (direction) (nearest town)

WELL PURPOSE: Home  
 (home, irrigation, municipal, industrial)

WELL COMPLETION DATA: 4 1/2" Drilled


- (1) diameter (inches) 2"
- (2) total depth (feet) 510
- (3) static water level (feet) 41' below top of ground.
- (4) casing Galv. Steel, 50.5'  
 (material) (depth)  
2" If telescope see back.  
 (size)
- (5) screen 5', 50.5'  
 (length) (depth to top)  
2", S. Steel  
 (size) (material)
- (6) pump 1 11  
 (HP) (yield gpm)  
Elec  
 (type power)
- (7) electric log NO  
 (yes or no)  
 \_\_\_\_\_  
 (organization running log)
- (8) how well bottom plugged B.W. Valve

description of formations encountered

from to


Surface Clay	0	18
Gravel	18	23
White Clay	23	55
Black Clay	55	70
Blue Clay	70	145
Sand	145	158
Blue Clay	158	235
Yellow sand	235	272
Blue Clay	272	470
Grey Sand	470	510

DRILLERS REMARKS:

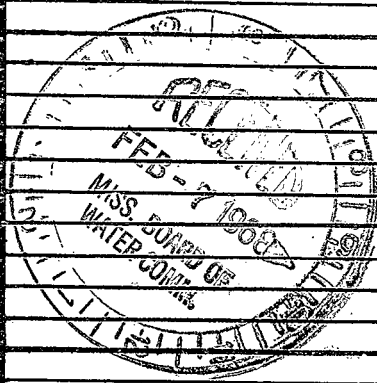

If well telescopes please sketch and show depths.

GROUND LEVEL

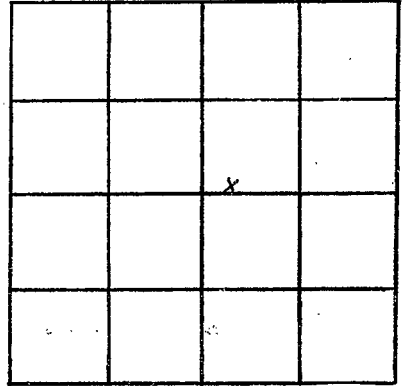

SECTION 5

Please indicate well location X.

ADDITIONAL INFORMATION

If more than one screen, show locations of each on sketch.