

PEARL River
 U 2009
 12-17-75

MISSISSIPPI
 BOARD OF WATER COMMISSIONERS
 416 North State Street
 Jackson, Mississippi 39201

WATER WELL DRILLERS LOG

12/17 1975 Bud ~~Montgomery~~ Son pearl river
 date well completed firm name county well located

LANDOWNER: Wilber ~~Jones~~

description of formations encountered

from to

Bayou Mass

white shale	0	35
steel pipe sand	35	90
blue shale	190	200
blue sand	200	305
blue shale	305	620
blue sand	620	875
blue shale	875	976
gray sand	976	1123

(mailing address)

WELL LOCATION:

Believe 2009 are good work
 276 T 65 N R 27 E 10 W
 2 miles north of Bayou Mass (direction) (nearest town)

WELL PURPOSE: home
 (home, irrigation, municipal, industrial)

WELL COMPLETION DATA:

- diameter (inches) 2
- total depth (feet) 1123
- static water level (feet) 12 below above top of ground.
- casing 400 1103 (material) (depth)
 24 (size) if telescope see back.
- screen 2x20 1103 (length) (depth to top)
 12 (size) 1 1/2" steel (material)
- pump 30 (HP) (yield gpm)
 (type power)
- electric log 30 (yes or no)
 (organization running log)
- how well bottom plugged
 sand shark


DRILLERS REMARKS:

APR 12 1976

MISS. Bd. OF WATER COMMISSIONERS

If well telescopes please sketch and show depths.

GROUND LEVEL

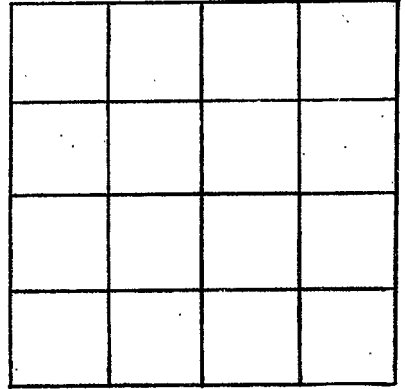

SECTION _____

Please indicate well location X.

ADDITIONAL INFORMATION

If more than one screen, show locations of each on sketch.