



Pearl River
U 2011
4-2-76

MISSISSIPPI
 BOARD OF WATER COMMISSIONERS
 416 North State Street
 Jackson, Mississippi 39201

13U

WATER WELL DRILLERS LOG

4-2 1976 Paul Kinton & Son Pearl River
 date well completed firm name county well located

LANDOWNER: James Hill
Route 2, Pearcy
Ms.
 (mailing address)

description of formations encountered	from	to
<u>Red shale</u>	<u>0</u>	<u>21</u>
<u>Red sand</u>	<u>21</u>	<u>63</u>
<u>Blue shale</u>	<u>63</u>	<u>285</u>
<u>Gray sand</u>	<u>253</u>	<u>285</u>

WELL LOCATION:
 sec. 26 T. 5 N. R. 17 E.
2 miles N of Pearcy
 (distance) (direction) (nearest town)

WELL PURPOSE: Home
 (home, irrigation, municipal, industrial)

WELL COMPLETION DATA:

- (1) diameter (inches) 2 in
- (2) total depth (feet) 285
- (3) static water level (feet) 46 below top of ground.
- (4) casing PVC 275
 (material) (depth)
 (size) If telescope see back.
- (5) screen 2x10 275
 (length) (depth to top)
PVC
 (size) (material)
- (6) pump 1 (HP) (yield gpm)
electric
 (type power)
- (7) electric log NO
 (yes or no)
 (organization running log)
- (8) how well bottom plugged

DRILLERS REMARKS: Shank


RECEIVED

SEP - 1 1976

MISS. Bd. OF WATER COMMISSIONERS

If well telescopes please sketch and show depths.

GROUND LEVEL

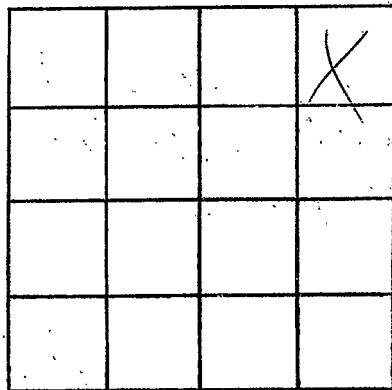

SECTION _____

Please indicate well location X.

ADDITIONAL INFORMATION

If more than one screen,
show locations of each on sketch.