

**MISSISSIPPI
BOARD OF WATER COMMISSIONERS**
416 North State Street
Jackson, Mississippi 39201

WATER WELL DRILLERS LOG

Pearl River
U 202
4-22-76

130

4-22
date well completed

1976 Bud Penton's Son Pearl River
firm name county well located

LANDOWNER: J. Smith

Route 1

Carrine, Mo.
(mailing address)

description of formations encountered

from to

Red Shale
White Sand

0	35
35	35

WELL LOCATION:

sec 9 T 5 N R 17 E
2 1/2 miles W of Carrine
(distance) (direction) (nearest town)

WELL PURPOSE: Home
(home, irrigation, municipal, industrial)

WELL COMPLETION DATA:

- (1) diameter (inches) 4 in
- (2) total depth (feet) 85
- (3) static water level (feet) 27 below above top of ground.
- (4) casing PVC, 75,
(material) (depth)

_____ if telescope see back.
(size)

- (5) screen 4 x 10, 75
(length) (depth to top)
PVC
(size) (material)

- (6) pump 1/2, _____
(HP) (yield gpm)
electric
(type power)

- (7) electric log NO
(yes or no)

_____ (organization running log)

- (8) how well bottom plugged Sand Shale


DRILLERS REMARKS: _____

RECEIVED
SEP - 1 1976

MISS. BU. OF WATER COMMISSIONERS

If well telescopes please sketch and show depths.

GROUND LEVEL

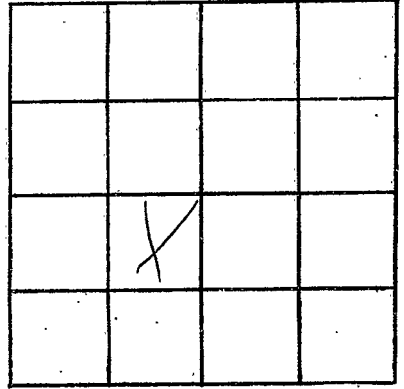

SECTION _____

Please indicate well location X.

ADDITIONAL INFORMATION

If more than one screen, show locations of each on sketch.