

Pearl River
 U 2016
 8-19-76

MISSISSIPPI
 BOARD OF WATER COMMISSIONERS
 416 North State Street
 Jackson, Mississippi 39201

WATER WELL DRILLERS LOG

8-19-76 ^{13V} Bud Ruten & Son Pearl River
 date well completed firm name county well located

LANDOWNER: Lodie Ruten
 Route 1,
 Canine, Mo.
 (mailing address)

description of formations
 encountered

from	to
0	40
40	90
90	175
175	200

Red Shale
 Red Sand
 Blue Shale
 White Sand

WELL LOCATION:

sec. 4 T 5 N R 17 E
 4 miles NW of Canine
 (distance) (direction) (nearest town)

WELL PURPOSE: Home
 (home, irrigation, municipal, industrial)

WELL COMPLETION DATA:

- (1) diameter (inches) 4 in
- (2) total depth (feet) 200
- (3) static water level (feet) 70 -below top of ground.
- (4) casing PVC, 195 (material), (depth)

if telescope see back.
 (size)

- (5) screen 5 195 (length) (depth to top)
 4x5 PVC (size) (material)

- (6) pump 1/2 600 (HP) (yield gpm)
 electric (type power)

- (7) electric log No (yes or no)

(organization running log)

- (8) how well bottom plugged Sand Shale

DRILLERS REMARKS:


RECEIVED

JAN 10 1977

MISS. BD. OF WATER COMMISSIONERS

If well telescopes please sketch and show depths.

GROUND LEVEL

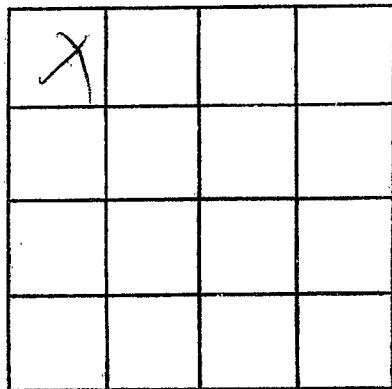

SECTION _____

Please indicate well location X.

ADDITIONAL INFORMATION

If more than one screen, show locations of each on sketch.