

Pearl River
 11 2007
 10-10-76

MISSISSIPPI
 BOARD OF WATER COMMISSIONERS
 416 North State Street
 Jackson, Mississippi 39201

WATER WELL DRILLERS LOG

10-10 date well completed 74 Bud Kuter's Son firm name Pearl River county well located

LANDOWNER:
 Carl G. Scott
 Rt. 1, Carriere, Mo.
 (mailing address)

description of formations encountered	from	to
	Red Shale	0
Red sand	40	95
Blue shale	95	275
Gray sand	275	295

WELL LOCATION:
 sec. 14 T. 5 N. R. 17 E
 S W
 1 miles W of Carriere
 (distance) (direction) (nearest town)

WELL PURPOSE: Home
 (home, irrigation, municipal, industrial)


- WELL COMPLETION DATA:
- (1) diameter (inches) 4 inch
 - (2) total depth (feet) 295
 - (3) static water level (feet) 114 below top of ground.
 - (4) casing PVC 285
 (material) (depth)
 - _____ if telescope see back.
 (size)
 - (5) screen 10 285
 (length) (depth to top)
 - 12 PVC
 (size) (material)
 - (6) pump 1 1/2 _____
 (HP) (yield gpm)
 - electric
 (type power)
 - (7) electric log No
 (yes or no)
 - _____ (organization running log)
 - (8) how well bottom plugged Sand Shale

DRILLERS REMARKS:

RECEIVED
 JAN 10 1977

If well telescopes please sketch and show depths.

GROUND LEVEL

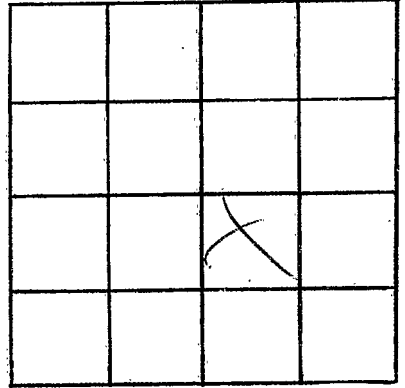

SECTION _____

Please indicate well location X.

ADDITIONAL INFORMATION

If more than one screen, show locations of each on sketch.