

Pearl River
U. 2018
2-2-77

MISSISSIPPI
 BOARD OF WATER COMMISSIONERS
 416 North State Street
 13^{1/2} Jackson, Mississippi 39201

WATER WELL DRILLERS LOG

2-2 1977 Bud Benton Pearl River
 date well completed firm name county well located

LANDOWNER:
Kenneth Thompson
Carrine, Ms.
 (mailing address)

description of formations encountered	from	to
<u>Red Shale</u>	<u>0</u>	<u>28</u>
<u>Red sand</u>	<u>28</u>	<u>53</u>
<u>Blue Shale</u>	<u>55</u>	<u>88</u>
<u>Gray sand</u>	<u>88</u>	<u>165</u>

WELL LOCATION:
 sec. 27 T. 5 N. R. 17 E.
8 1/2 miles W of Picayune
 (distance) (direction) (nearest town)

WELL PURPOSE: Home
 (home, irrigation, municipal, industrial)

WELL COMPLETION DATA:

(1) diameter (inches) 2 1/2

(2) total depth (feet) 113

(3) static water level (feet) 35 below above top of ground.

(4) casing PVC 100
 (material) (depth)
 (size) If telescope see back.

(5) screen 5 110
 (length) (depth to top)
2 PVC
 (size) (material)

(6) pump 1 675 W
 (HP) (yield gpm)
electric
 (type power)

(7) electric log No
 (yes or no)

(organization running log)

(8) how well bottom plugged
Sand Shail

DRILLERS REMARKS:


RECEIVED

APR 15 1977

MISS. BD. OF WATER COMMISSIONERS

If well telescopes please sketch and show depths.

GROUND LEVEL

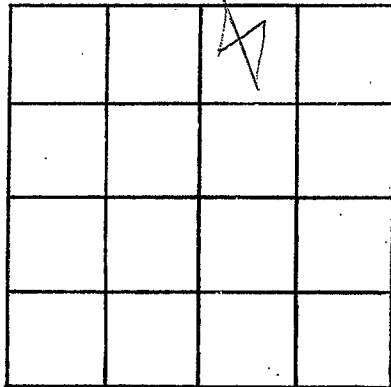

SECTION _____

Please indicate well location X.

ADDITIONAL INFORMATION

If more than one screen,
show locations of each on sketch.