

Pearl River
U 200
3-24-77

MISSISSIPPI
 BOARD OF WATER COMMISSIONERS
 416 North State Street
 Jackson, Mississippi 39201

WATER WELL DRILLERS LOG

These people seem to make up

3-24 1977 Bud Denton Pearl River
 date well completed firm name county well located

LANDOWNER:
Lester Vandrell
Rob. Carrine, Miss.
 (mailing address)

description of formations encountered	from	to
<u>Red Shale</u>	<u>0</u>	<u>25</u>
<u>White Sand</u>	<u>25</u>	<u>55</u>
<u>Blue Shale</u>	<u>55</u>	<u>107</u>
<u>Gray Sand</u>	<u>107</u>	<u>242</u>

WELL LOCATION:
 sec. 9 T. 5 N. R. 15 E
2 1/2 miles W of Carrine
 (distance) (direction) (nearest town)

WELL PURPOSE: Home
 (home, irrigation, municipal, industrial)

- WELL COMPLETION DATA:
- (1) diameter (inches) 2 in
 - (2) total depth (feet) 242
 - (3) static water level (feet) 15 below top of ground.
 - (4) casing Galv., 232
 (material) (depth)
 (size) if telescope see back.
 - (5) screen 10, 232
 (length) (depth to top)
2 in, S. Steel
 (size) (material)
 - (6) pump 1, 1250 M
 (HP) (yield gpm)
electric
 (type power)
 - (7) electric log No
 (yes or no)

(organization running log)
 (8) how well bottom plugged
Sand stuck


DRILLERS REMARKS:

RECEIVED
 APR 15 1977

MISS. BD. OF WATER COMMISSIONERS

If well telescopes please
sketch and show depths.

GROUND LEVEL

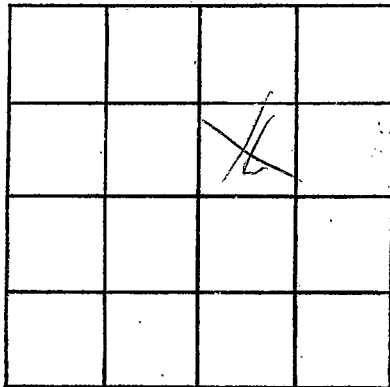

SECTION _____

Please indicate well location X.

ADDITIONAL INFORMATION

If more than one screen,
show locations of each on sketch.