

Pearl R.
 U 2020
 7/29/77

MISSISSIPPI
 BOARD OF WATER COMMISSIONERS
 416 North State Street
 Jackson, Mississippi 39201

WATER WELL DRILLERS LOG

7-29 date well completed 1977 Bud Center firm name Pearl River county well located

LANDOWNER:
 W.W. Creel
 Decatur, Miss.
 (mailing address)

description of formations encountered	from	to
White Shale	0	30
Sand & Rock	30	58

WELL LOCATION:
 sec. 26 T. 5 N. R. 17 E.
 3 miles NW of Decatur
 (distance) (direction) (nearest town)

WELL PURPOSE: Home
 (home, irrigation, municipal, industrial)

WELL COMPLETION DATA:

(1) diameter (inches) 2

(2) total depth (feet) 58

(3) static water level (feet) 12 below top of ground.

(4) casing PVC, 53 (material), (depth)

(size) if telescope see back.

(5) screen 2x5, 53 (length), (depth to top)
 12 PVC (size), (material)

(6) pump 1/2 (HP), 3.5 (yield gpm)

(type power) 5.5

(7) electric log NO 9pm (yes or no)

(organization running log)


(8) how well bottom plugged
 Sand Stack

DRILLERS REMARKS:

RECEIVED
 DEC 30 1977

If well telescopes please sketch and show depths.

GROUND LEVEL

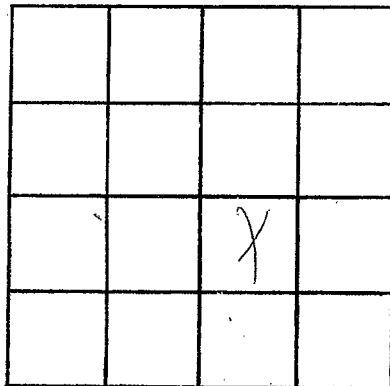

SECTION _____

Please indicate well location X.

ADDITIONAL INFORMATION

If more than one screen, show locations of each on sketch.