

Pearl R.  
 U 2021  
 9/29/77

MISSISSIPPI  
 BOARD OF WATER COMMISSIONERS  
 416 North State Street  
 Jackson, Mississippi 39201

WATER WELL DRILLERS LOG

9-29 date well completed      77 Bud Benton firm name      Pearl River county well located

LANDOWNER:  
 Ronald Thompson  
 Carriere, Mo.  
 (mailing address)

| description of formations encountered | from | to  |
|---------------------------------------|------|-----|
| Red Shale                             | 0    | 60  |
| White Sand                            | 60   | 70  |
| Grey Shale                            | 70   | 101 |
| Grey Sand                             | 101  | 131 |

WELL LOCATION:  
 sec. 26 T. 5 N. R. 17 E.  
 7 miles W of Carriere  
 (distance) (direction) (nearest town)

WELL PURPOSE: Home  
 (home, irrigation, municipal, industrial)

- WELL COMPLETION DATA:
- (1) diameter (inches) 4 in
  - (2) total depth (feet) 131
  - (3) static water level (feet) 45 below top of ground.
  - (4) casing PVC, 121 (material) (depth)
  - (size) if telescope see back.
  - (5) screen 4x10, 121 (length) (depth to top)
  - 12 PVC (size) (material)
  - (6) pump 1/2 HP, 650 (yield gpm)
  - electric 119pm (type power)
  - (7) electric log NO (yes or no)

(organization running log)

(8) how well bottom plugged Sand Shale


DRILLERS REMARKS:

RECEIVED  
 DEC 30 1977

MISS. BD. OF WATER COMM.

If well telescopes please sketch and show depths.

GROUND LEVEL

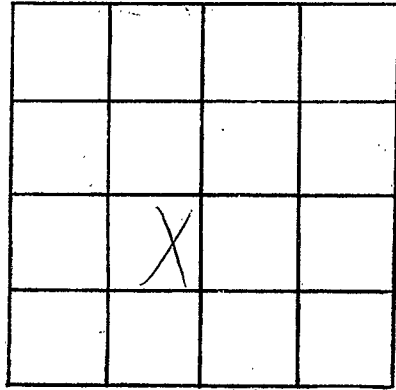

SECTION \_\_\_\_\_

Please indicate well location X.

ADDITIONAL INFORMATION

If more than one screen, show locations of each on sketch.