

Pearl River
 U 2022
 1/28/78

MISSISSIPPI
 BOARD OF WATER COMMISSIONERS
 416 North State Street
 Jackson, Mississippi 39201

WATER WELL DRILLERS LOG

1-28 1978 Kousney water well Pearl River
 date well completed firm name county well located

LANDOWNER: R. V. Mathis
 RFD Precinct
 Fox Run Road
 (mailing address)

description of formations encountered	from	to
	Gravel	0
sd. sand	280	305

WELL LOCATION:
 sec. 29 T 5 N R 17 E
 3 miles SW of Pearl River
 (distance) (direction) (nearest town)

WELL PURPOSE: Home
 (home, irrigation, municipal, industrial)


- WELL COMPLETION DATA:
- (1) diameter (inches) 2
 - (2) total depth (feet) 305
 - (3) static water level (feet) 160 below top of ground.
 - (4) casing galv. steel (material) 295 (depth)
 - (size) if telescope see back.
 - (5) screen 10 (length) Stainless (depth to top)
 - (size) (material) 2 Stainless
 - (6) pump 2 (HP) 1 (yield gpm)
 - (type power) AC
 - (7) electric log yes (yes or no)
 - (organization running log) Seaboard
 - (8) how well bottom plugged Seaboard

RECEIVED
 MAR 31 1978

DRILLERS REMARKS:

If well telescopes please sketch and show depths.

GROUND LEVEL

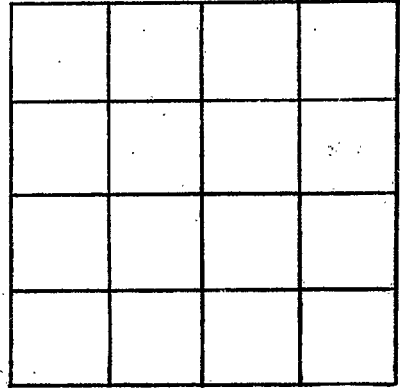

SECTION _____

Please indicate well location X.

ADDITIONAL INFORMATION

If more than one screen,
show locations of each on sketch.