

PEARL RIVER

MISSISSIPPI
BOARD OF WATER COMMISSIONERS
416 North State Street
Jackson, Mississippi 39201

U 223

4/19/78

WATER WELL DRILLERS LOG

4/19
date well completed

1978 Bud Pentek Son Pearl River
firm name

Pearl River
county well located

LANDOWNER: Nelson Ludy
R T-1 Box
Carriermass
(mailing address)

description of formations encountered	from	to
Red Shale	0	60
Red Sand	60	78
Light Shale	78	120
Dark Sand	120	195

WELL LOCATION:

sec. 9 T. 5 N R. 17 E
4 miles W of Carriermass
(distance) (direction) (nearest town)

WELL PURPOSE: home
(home, irrigation, municipal, industrial)

WELL COMPLETION DATA:

- (1) diameter (inches) 4"
- (2) total depth (feet) 195
- (3) static water level (feet) 45' below top of ground
- (4) casing PVC 185' (material) (depth)
20" If telescope see back. (size)
- (5) screen 4x10 185' (length) (depth to top)
12" PVC (size) (material)
- (6) pump 1/2 HP 750 (yield gpm)
Elect (type power)
- (7) electric log NO (yes or no)


(organization running log)

(8) how well bottom plugged

DRILLERS REMARKS:

If well telescopes please sketch and show depths.

GROUND LEVEL

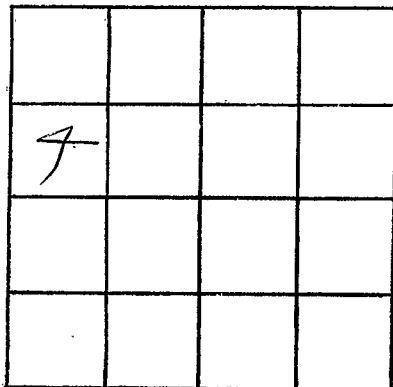

SECTION _____

Please indicate well location X.

ADDITIONAL INFORMATION

If more than one screen,
show locations of each on sketch.