

PEARL RIVER

MISSISSIPPI  
BOARD OF WATER COMMISSIONERS  
416 North State Street  
Jackson, Mississippi 39201

2024 U

3/14/78

WATER WELL DRILLERS LOG

3/14 date well completed 1978 Bob Pentecost Sons firm name Pearl River county well located

LANDOWNER: Jones Kennedy  
B.T. Bot  
Carriere Miss.  
(mailing address)

description of formations encountered	from	to
<u>Red Shell</u>		<u>0 38</u>
<u>White sand</u>	<u>38</u>	<u>56</u>
<u>Blue sand</u>	<u>56</u>	<u>260</u>
<u>Blue shale</u>	<u>265</u>	<u>375</u>
<u>Blue sand</u>	<u>375</u>	<u>360</u>
<u>Blue shale</u>	<u>360</u>	<u>470</u>
<u>Blue sand</u>	<u>470</u>	<u>525</u>

WELL LOCATION:  
sec. 4 T 5 N R 17 E  
(3) miles W of Carriere  
(distance) (direction) (nearest town)

WELL PURPOSE: Home  
(home, irrigation, municipal, industrial)

- WELL COMPLETION DATA:
- (1) diameter (inches) 4"
  - (2) total depth (feet) 525
  - (3) static water level (feet) 27 below top of ground.
  - (4) casing PVC, 495  
(material) (depth)
  - 30 if telescope see back.  
(size)
  - (5) screen 4x10, 495  
(length) (depth to top)
  - 12, PVC  
(size) (material)
  - (6) pump 1, 1650  
(HP) (yield gpm)
  - Elect  
(type power)
  - (7) electric log NO  
(yes or no)

running log


RECEIVED

JUL 14 1978

MISS. BD. OF WATER COMMISSIONERS

If well telescopes please sketch and show depths.

GROUND LEVEL

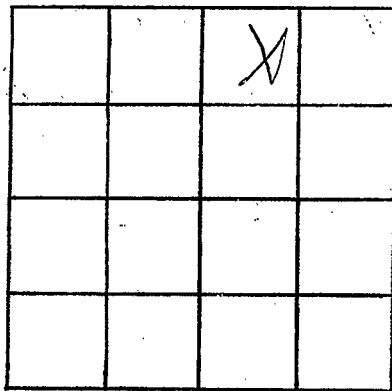

SECTION \_\_\_\_\_

Please indicate well location X.

ADDITIONAL INFORMATION

Lined area for additional information.

If more than one screen, show locations of each on sketch.