

PEARL RIVER

U 2025

9-20-78

MISSISSIPPI BOARD OF WATER COMMISSIONERS  
416 North State Street  
Jackson, Mississippi 39201

WATER WELL DRILLERS LOG

9/20

1978 Bullington

Pearl River

date well completed

firm name

county well located

LANDOWNER: Bank

description of formations encountered

from

to

Bushes  
R.F. L. Bot  
Carrier (mailing address)

Red shale 0 30  
Blue shale 30 160  
Gray sand 160 192

WELL LOCATION:

sec. 9 T 5 N R 17 E  
S W  
4 miles W of Carrier  
(distance) (direction) (nearest town)

WELL PURPOSE: home  
(home, irrigation, municipal, industrial)

WELL COMPLETION DATA:

- (1) diameter (inches) 4"
- (2) total depth (feet) 192
- (3) static water level (feet) 56 below top of ground.
- (4) casing PVC 182  
(material) (depth)
- no if telescope see back.  
(size)
- (5) screen 4x10 182  
(length) (depth to top)
- 12 PVC  
(size) (material)
- (6) pump 1 1350  
(HP) (yield gpm)
- Elect  
(type power)
- (7) electric log no  
(yes or no)

(organization running log)

well bottom plugged


REMARKS:

RECEIVED  
OCT 4 1978

MISS. Bd. OF WATER COMM

If well telescopes please sketch and show depths.

GROUND LEVEL

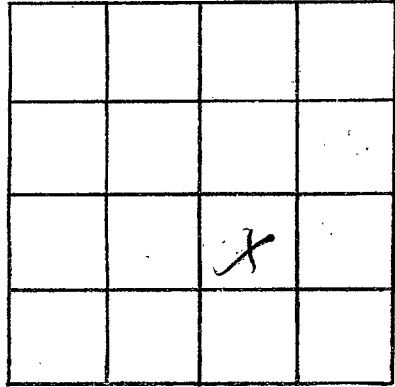

SECTION \_\_\_\_\_

Please indicate well location X.

ADDITIONAL INFORMATION

If more than one screen,  
show locations of each on sketch.