

PEARL RIVER
 U 2026
 9-20-78

MISSISSIPPI
 BOARD OF WATER COMMISSIONERS
 416 North State Street
 Jackson, Mississippi 39201

WATER WELL DRILLERS LOG

9/20 1978 Red Penton Inc Pearl River
 date well completed firm name county well located

LANDOWNER: Mrs Vandrey
P.O. Box
Carrier Miss
 (mailing address)

description of formations encountered	from	to
<u>Red shale</u>	<u>0</u>	<u>18</u>
<u>White sand</u>	<u>18</u>	<u>65</u>
<u>Blue shale</u>	<u>65</u>	<u>200</u>
<u>Drif sand</u>	<u>200</u>	<u>246</u>

WELL LOCATION:
 sec. 9 T. 5 N R. 17 E
4 miles W of Carrier
 (distance) (direction) (nearest town)

WELL PURPOSE: None
 (home, irrigation, municipal, industrial)

WELL COMPLETION DATA:

(1) diameter (inches) 2 1/2

(2) total depth (feet) 246

(3) static water level (feet) 24 below above top of ground.

(4) casing Galv. 236
 (material) (depth)
no if telescope see back.
 (size)

(5) screens 2 1/2 236
 (length) (depth to top)
12 steel
 (size) (material)

(6) pump 1 660
 (HP) (yield gpm)
Elect
 (type power)

(7) electric log no
 (yes or no)

(organization running log)

(8) how well bottom plugged


DRILLERS REMARKS:
[Signature]

RECEIVED
 OCT 4 1978

MISS. BD. OF WATER COMM

If well telescopes please sketch and show depths.

GROUND LEVEL

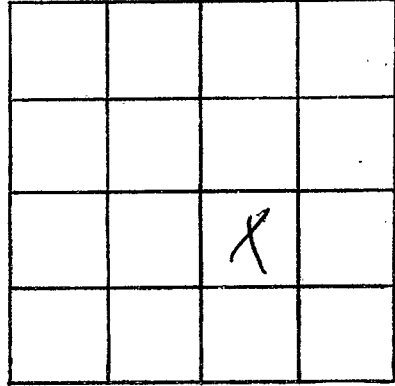

SECTION _____

Please indicate well location X.

ADDITIONAL INFORMATION

If more than one screen,
show locations of each on sketch.