

PAERL RIVER

2027 U

9-22-78

MISSISSIPPI BOARD OF WATER COMMISSIONERS  
416 North State Street  
Jackson, Mississippi 39201

WATER WELL DRILLERS LOG

9/22 19 Budgentonson Paul River  
date well completed firm name county well located

LANDOWNER: M. Smith

description of formations encountered

from to

murphre  
RT. 1 Box 79  
(mailing address)

Red shale 0 25  
Blue shale 25 70  
Gray sand 70 170  
170 192

WELL LOCATION:

sec. 14 T. 5 N R. 17 E  
1 1/2 miles W of Carriere  
(distance) (direction) (nearest town)

WELL PURPOSE: Home  
(home, irrigation, municipal, industrial)

WELL COMPLETION DATA:

- (1) diameter (inches) 4 1/2"
- (2) total depth (feet) 179 1/2
- (3) static water level (feet) 105 below top of ground.
- (4) casing PVC 182  
(material) (depth)  
30 if telescope see back.  
(size)
- (5) screen 4x10 182  
(length) (depth to top)  
12 PVC  
(size) (material)
- (6) pump 1 1205  
(HP) (yield gpm)  
Elect.  
(type power)
- (7) electric log NO  
(yes or no)

(organization running log)

(8) how well bottom plugged Sp


DRILLERS REMARKS: Shank

RECEIVED  
OCT 1 1978

MISS. BD. OF WATER COMMISSIONERS

If well telescopes please sketch and show depths.

GROUND LEVEL

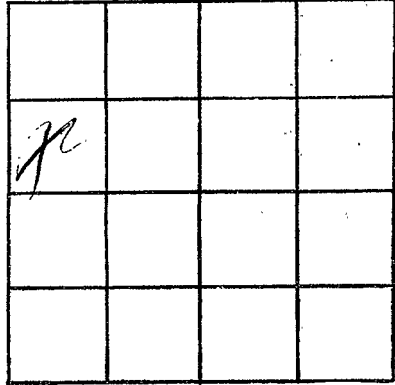

SECTION \_\_\_\_\_

Please indicate well location X.

ADDITIONAL INFORMATION

If more than one screen,  
show locations of each on sketch.