

PEARL RIVER

U 2028

11-02-78

MISSISSIPPI BOARD OF WATER COMMISSIONERS 416 North State Street Jackson, Mississippi 39201

WATER WELL DRILLERS LOG

11/3 date well completed 1978 Bud Denton & Son Pearl River firm name county well located

| LANDOWNER: | description of formations encountered | from | to |
|---------------------------------------|---------------------------------------|------|-----|
| Frank Medow | Red shale | 0 | 43 |
| B.T. Co 190 Carrier | Sand gravel | 45 | 90 |
| Miss | Blue shale | 90 | 175 |
| (mailing address) | Blue sand | 175 | 219 |
| WELL LOCATION: | Blue shale | 219 | 365 |
| sec 28 T 75 N R 76 E | Blue sand | 365 | 405 |
| 4 miles W of Carrier | Blue shale | 405 | 475 |
| (distance) (direction) (nearest town) | Blue sand | 475 | 508 |

WELL PURPOSE: home (home, irrigation, municipal, industrial)


WELL COMPLETION DATA:

- (1) diameter (inches) 4 1/2
- (2) total depth (feet) 508
- (3) static water level (feet) 58 below top of ground.
- (4) casing (material) Galv (depth) 498
- 4 1/2 (size) if telescope see back.
- (5) screen (length) 10 (depth to top) 498
- 12 (size) (material) Steel
- (6) pump (HP) 1 (yield gpm) 1750
- Elect. (type power) 9PH
- (7) electric log no (yes or no)

(organization running log)

(8) how well bottom plugged Sand Shale


DRILLERS REMARKS:

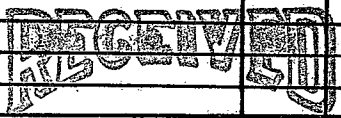

JAN 26 1978

If well telescopes please sketch and show depths.

GROUND LEVEL

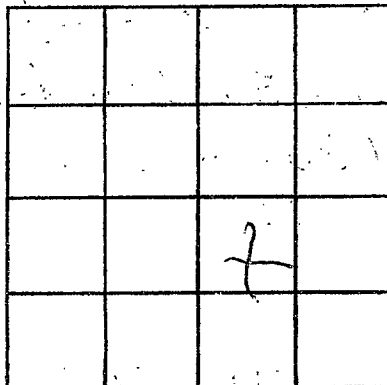

SECTION _____

Please indicate well location X.

ADDITIONAL INFORMATION

If more than one screen,
show locations of each on sketch.