

PEARL RIVER  
 U 2007  
 1-04-79

MISSISSIPPI  
 BOARD OF WATER COMMISSIONERS 6  
 416 North State Street  
 Jackson, Mississippi 39201

WATER WELL DRILLERS LOG

1/24 1979 Bud Benton & Son Pearl River  
 date well completed firm name county well located

LANDOWNER: Eugene Seal  
 R.T. 1 - Bot  
 Carriere Miss.  
 (mailing address)

description of formations encountered	from	to
Red Shale	0	35
Blue Shale	35	70
Blue Sand	70	215

WELL LOCATION:  
 sec. 15 T. 5 N R. 17 E  
 4 miles N of Bogalusa  
 (distance) (direction) (nearest town)

WELL PURPOSE: Home  
 (home, irrigation, municipal, industrial)

WELL COMPLETION DATA:

(1) diameter (inches) 2

(2) total depth (feet) 215

(3) static water level (feet) 52 below top of ground.

(4) casing PVC 215  
 (material) (depth)

(size) If telescope see back.

(5) screen 2x10 205  
 (length) (depth to top)

12 PVC  
 (size) (material)

(6) pump 1 530  
 (HP) (yield gpm)

Elect  
 (type power)

(7) electric log No  
 (yes or no)

(organization running log)

(8) how well bottom plugged  
 Bud Sharp

DRILLERS REMARKS:


Miss. Board of Water Comm.

FEB 26 1979

RECEIVED

If well telescopes please sketch and show depths.

GROUND LEVEL

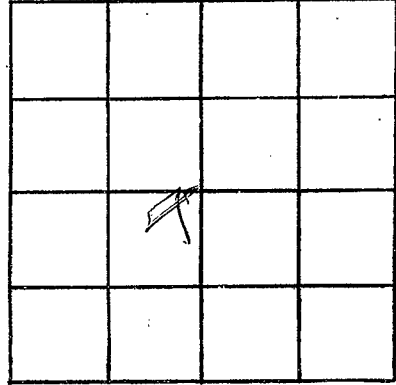

SECTION \_\_\_\_\_

Please indicate well location X.

ADDITIONAL INFORMATION

If more than one screen, show locations of each on sketch.