

Parl River
U 2031
5/23/79

MISSISSIPPI
 BOARD OF WATER COMMISSIONERS
 416 North State Street
 Jackson, Mississippi 39201

WATER WELL DRILLERS LOG

5/23 date well completed 1979 Red-Renton Water Well Parl River firm name county well located

LANDOWNER: Shane Powers
Pot 144 Piquette Miss
 (mailing address)

description of formations encountered	from	to
<u>Red shale</u>	<u>6</u>	<u>12</u>
<u>white sand</u>	<u>12</u>	<u>30</u>
<u>Blue shale</u>	<u>30</u>	<u>175</u>
<u>Gray sand</u>	<u>175</u>	<u>192</u>

WELL LOCATION:
 sec. 7 T. 5 N. R. 17 E.
2 miles N of Piquette
 (distance) (direction) (nearest town)

WELL PURPOSE: Home
 (home, irrigation, municipal, industrial)

- WELL COMPLETION DATA:
- (1) diameter (inches) 2"
 - (2) total depth (feet) 192
 - (3) static water level (feet) 42 below top of ground.
 - (4) casing PVC, 192,
 (material) (depth)
 (size) if telescope see back.
 - (5) screen 2x10, 18"
 (length) (depth to top)
12, PVC
 (size) (material)
 - (6) pump 3/4, 450
 (HP) (yield gpm)
Elect.
 (type power)
 - (7) electric log no
 (yes or no)
 (organization running log)

(8) how well bottom plugged Spd
Shark
 DRILLERS REMARKS


Miss. Board of Water Comm.

JUL 30 1979

RECEIVED

If well telescopes please sketch and show depths.

GROUND LEVEL

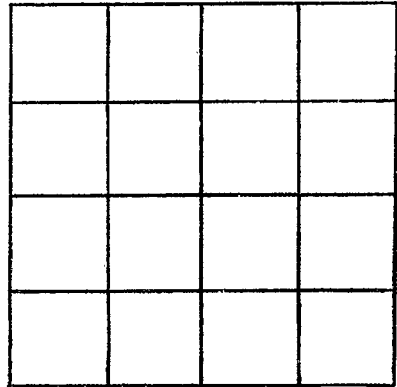

SECTION _____

Please indicate well location X.

ADDITIONAL INFORMATION

A series of horizontal lines for recording additional information, starting below the 'ADDITIONAL INFORMATION' header and extending to the bottom of the page.

If more than one screen, show locations of each on sketch.