

Pearl River
 U 2032
 3/12/79

MISSISSIPPI
 BOARD OF WATER COMMISSIONERS
 416 North State Street
 Jackson, Mississippi 39201

WATER WELL DRILLERS LOG

3/12 1979 Bud Patton Pearl River
 date well completed firm name county well located

LANDOWNER: Steve Boudreau
 1119 Parkwood Circle
 Piquette Miss.
 (mailing address)

description of formations encountered	from	to
Red shale	0	201
W hills sand	201	235

WELL LOCATION:
 sec. 7 T. 5 N R. 17 E
 S W
 2 miles NE of Piquette
 (distance) (direction) (nearest town)

WELL PURPOSE: none
 (home, irrigation, municipal, industrial)

- WELL COMPLETION DATA:
- (1) diameter (inches) 2
 - (2) total depth (feet) 125
 - (3) static water level (feet) 42 below above top of ground.
 - (4) casing PVC, 125 (material) (depth)
 - (size) If telescope see back.
 - (5) screen 2x10, 115 (length) (depth to top)
 - 12, PVC (size) (material)
 - (6) pump 1/2, 530 (HP) (yield gpm)
 - Elect. (type power)
 - (7) electric log NO (yes or no)

(organization running log)
 (8) how well bottom plugged
 Sharp

DRILLERS REMARKS:


Miss. Board of Water Comm.

JUL 30 1979

RECEIVED

If well telescopes please sketch and show depths.

GROUND LEVEL

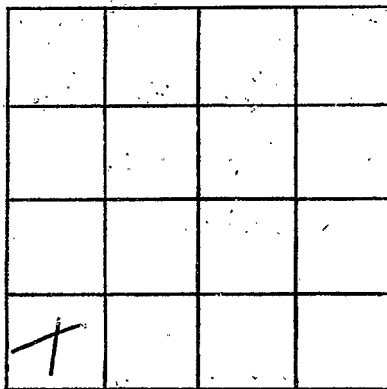

SECTION _____

Please indicate well location X.

ADDITIONAL INFORMATION

If more than one screen, show locations of each on sketch.