

**MISSISSIPPI  
BOARD OF WATER COMMISSIONERS**  
416 North State Street  
Jackson, Mississippi 39201

**WATER WELL DRILLERS LOG**

Pearl River  
U 2033  
3-13-79

3/13 1979 Bud Patton Pearl River  
date well completed firm name county well located

LANDOWNER: A.W. Adams  
Picayune Miss  
  
(mailing address)

description of formations encountered	from	to
<u>Red shale</u>	<u>0</u>	<u>22</u>
<u>white sand</u>	<u>22</u>	<u>30</u>
<u>Blue shale</u>	<u>30</u>	<u>180</u>
<u>Blue sand</u>	<u>180</u>	<u>200</u>

WELL LOCATION:  
sec. 7 T-5 N R-17 E  
S W  
2 miles N of Picayune  
(distance) (direction) (nearest town)

WELL PURPOSE: home  
(home, irrigation, municipal, industrial)

- WELL COMPLETION DATA:
- (1) diameter (inches) 2"
  - (2) total depth (feet) 200
  - (3) static water level (feet) 45 below above top of ground.
  - (4) casing PVC, 200,  
(material) (depth)  
         if telescoped see back.  
(size)
  - (5) screen 2x10, 190  
(length) (depth to top)  
         (size)          (material)
  - (6) pump          (HP)          (yield gpm)  
         (type power)
  - (7) electric log          (yes or no)  
         (organization running log)
  - (8) how well bottom plugged

DRILLERS REMARKS:         


Miss. Board of Water Comm.

JUL 30 1979

RECEIVED

If well telescopes please sketch and show depths.

GROUND LEVEL

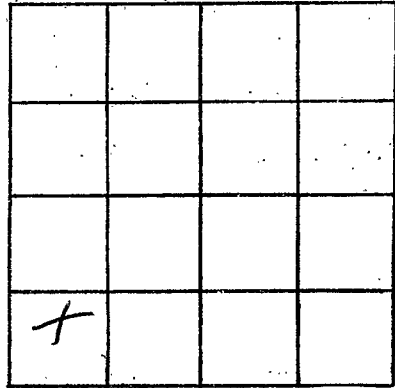

SECTION \_\_\_\_\_

Please indicate well location X.

ADDITIONAL INFORMATION

If more than one screen,  
show locations of each on sketch.