

Pearl River
U 2030

MISSISSIPPI
BOARD OF WATER COMMISSIONERS
416 North State Street
Jackson, Mississippi 39201

11-28-79
11/28
date well completed

1979 Bud Parton
firm name

Pearl River
county well located

WATER WELL DRILLERS LOG

LANDOWNER: Bill Archie
R.T. 1 Carriere Miss
(mailing address)

description of formations encountered	from	to
Red shale	0	26
White sand	26	70
Blue shale	70	675
Gravel sand	675	730

WELL LOCATION:
sec. 27 T. 4 N. R. 17 E
4 miles West of Carriere
(distance) (direction) (nearest town)

WELL PURPOSE: home
(home, irrigation, municipal, industrial)

WELL COMPLETION DATA:

(1) diameter (inches) 4"

(2) total depth (feet) 730

(3) static water level (feet) 14 below top of ground.

(4) casing PVC, 700 (material) (depth)

no If telescope see back. (size)

(5) screen 4x30, 700 (length) (depth to top)

12 PVC (size) (material)

(6) pump no (HP) (yield gpm)

(type power)

(7) electric log no (yes or no)

(organization running log)

(8) how well bottom plugged
Sand stuck

DRILLERS REMARKS:


DEPT. OF NATURAL RESOURCES
BUREAU OF LAND & WATER RESOURCES

JAN 7 1980

RECEIVED

If well telescopes please sketch and show depths.

GROUND LEVEL

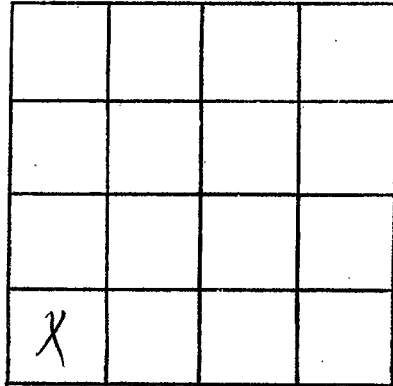

SECTION _____

Please indicate well location X.

ADDITIONAL INFORMATION

If more than one screen,
show locations of each on sketch.
