

Pearl River
 U 2037
 5/23/80

MISSISSIPPI
 BOARD OF WATER COMMISSIONERS
 416 North State Street
 Jackson, Mississippi 39201

WATER WELL DRILLERS LOG

11 date well completed 1979 *and partner water well Pearl River* firm name county well located

LANDOWNER: *James Strickland*
Diagnose well -
R-T-3
 (mailing address)

description of formations encountered	from	to
<i>Red shale</i>	<i>0</i>	<i>30</i>
<i>white sand</i>	<i>30</i>	<i>25-</i>

WELL LOCATION:
 sec. 25 T. 5 N. R. 17 E
3 miles W of Jones
 (distance) (direction) (nearest town)

WELL PURPOSE: *None*
 (home, irrigation, municipal, industrial)

- WELL COMPLETION DATA:
- (1) diameter (inches) 2"
 - (2) total depth (feet) 65-
 - (3) static water level (feet) 8 below above top of ground.
 - (4) casing PVC, 53-
(material) (depth)
(size) if telescope see back.
 - (5) screen 10, 53-
(length) (depth to top)
12, PVC
(size) (material)
 - (6) pump 3/4, 5-50
(HP) (yield gpm)
elect.
(type power)
 - (7) electric log no
(yes or no)

(organization running log)
 (8) how well bottom plugged *shut*

DRILLERS REMARKS:


DEPT. OF NATURAL RESOURCES
 BUREAU OF LAND & WATER RESOURCES

MAY 10 1980

RECEIVED

If well telescopes please sketch and show depths.

GROUND LEVEL

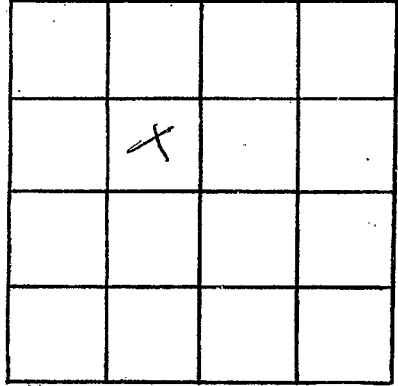

SECTION _____

Please indicate well location X.

ADDITIONAL INFORMATION

A series of horizontal lines for writing additional information.

If more than one screen, show locations of each on sketch.