

Pearl River
 U 2041
 8-16-80

MISSISSIPPI
 BOARD OF WATER COMMISSIONERS
 416 North State Street
 Jackson, Mississippi 39201

WATER WELL DRILLERS LOG

8/16 1980 Red Penton water Pearl River
 date well completed well service firm name county well located

LANDOWNER: Bob. White

R.T.1 carrier in

(mailing address)

WELL LOCATION:
 sec. 4 T. 4 N R. 17 E
 4 miles west of Carrier
 (distance) (direction) (nearest town)

WELL PURPOSE: Home
 (home, irrigation, municipal, industrial)

WELL COMPLETION DATA:

- (1) diameter (inches) 4"
- (2) total depth (feet) 286
- (3) static water level (feet) 67 below top of ground.
- (4) casing PVC, 276 (material) (depth)
- (size) if telescope see back.
- (5) screen 12, 276 (length) (depth to top)
- (size) (material)
- (6) pump 3/4, 960 m (HP) (yield gpm)
- (type power)
- (7) electric log no (yes or no)

(organization running log)

(8) how well bottom plugged
 Sherk

DRILLERS REMARKS:

description of formations encountered	from	to
Red shale	0	16
Red sand	16	22
Blue shale	22	220
W. bent sand	220	286


DEPT. OF NATURAL RESOURCES
 BUREAU OF LAND & WATER RESOURCES

OCT - 3 1980

RECEIVED

If well telescopes please sketch and show depths.

GROUND LEVEL

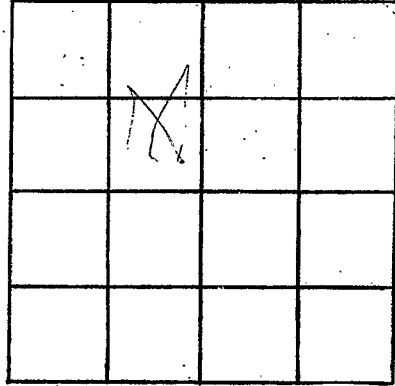

SECTION _____

Please indicate well location X.

ADDITIONAL INFORMATION

If more than one screen, show locations of each on sketch.