

PEARL RIVER
U. 2042
8/15/80
8-15 1980

MISSISSIPPI
 BOARD OF WATER COMMISSIONERS
 416 North State Street
 Jackson, Mississippi 39201



WATER WELL DRILLERS LOG

BOUNGEY WATER WELL DRILLING

date well completed

firm name

county well located

LANDOWNER: Bill & Jack

description of formations encountered

from

to

Hatchers
Rt. 1 Box 308 Carnie
 (mailing address) MS 39466

	<u>top</u>	<u>0</u>	<u>8</u>
	<u>sd ground</u>	<u>8</u>	<u>51</u>

WELL LOCATION:

sec. 28 T. 5 N. R. 17 E.
1 miles N of Picayune
 (distance) (direction) (nearest town)

WELL PURPOSE: Business
 (home, irrigation, municipal, industrial)

WELL COMPLETION DATA:


- (1) diameter (inches) 2
- (2) total depth (feet) 51
- (3) static water level (feet) 10 below above top of ground
- (4) casing PVC 41
 (material) (depth)
2 if telescope see back.
 (size)
- (5) screen 10 41
 (length) (depth to top)
2 PVC
 (size) (material)
- (6) pump 1/2 10
 (HP) (yield gpm)
AC
 (type power)
- (7) electric log _____
 (yes or no)

 (organization running log)
- (8) how well bottom plugged _____

DRILLERS REMARKS: Top
Skating Rock Touched


DEPT. OF NATURAL RESOURCES
 BUREAU OF LAND & WATER RESOURCES

MAR 13 1981

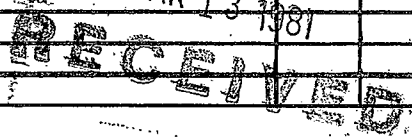

If well telescopes please sketch and show depths.

GROUND LEVEL

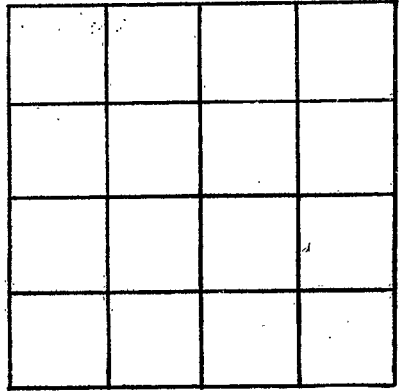

SECTION _____

Please indicate well location X.

ADDITIONAL INFORMATION

If more than one screen,
show locations of each on sketch.